

NOV - 5 1996

WATER RESOURCES DEPT
SALEM, OREGON

T 29 S, R 4 W WM

DIVERSION POINT #2 IS
660 FEET SOUTH AND
190 FEET WEST FROM THE
CENTER 1/4 CORNER
SECTION 14

CENTER 1/4 CORNER
SECTION 14

MAP BASED ON FINAL PROOF
SURVEY FOR PERMIT 33250

SCALE 1"=400'

OLD P.O.D. IS N 11° 05' E
7.44 CH. FROM 1/4 CORNER
BETWEEN SECTIONS 11 & 14,
BEING WITHIN SW1/4 SE1/4
SECTION 11, T.29S. R.4.W., W.M.

NE1/4 SW1/4

SE1/4 SW1/4

N 0° 55' W

1/4

S 11


S 14

CORNER

DIVERSION POINT #1
IS 710 FEET NORTH
AND 570 FEET WEST
FROM THE S 1/4
CORNER OF S. 14

SOUTH 1/4 CORNER
SECTION 14

THIS MAP TO BE USED FOR WATER RIGHT PURPOSES ONLY

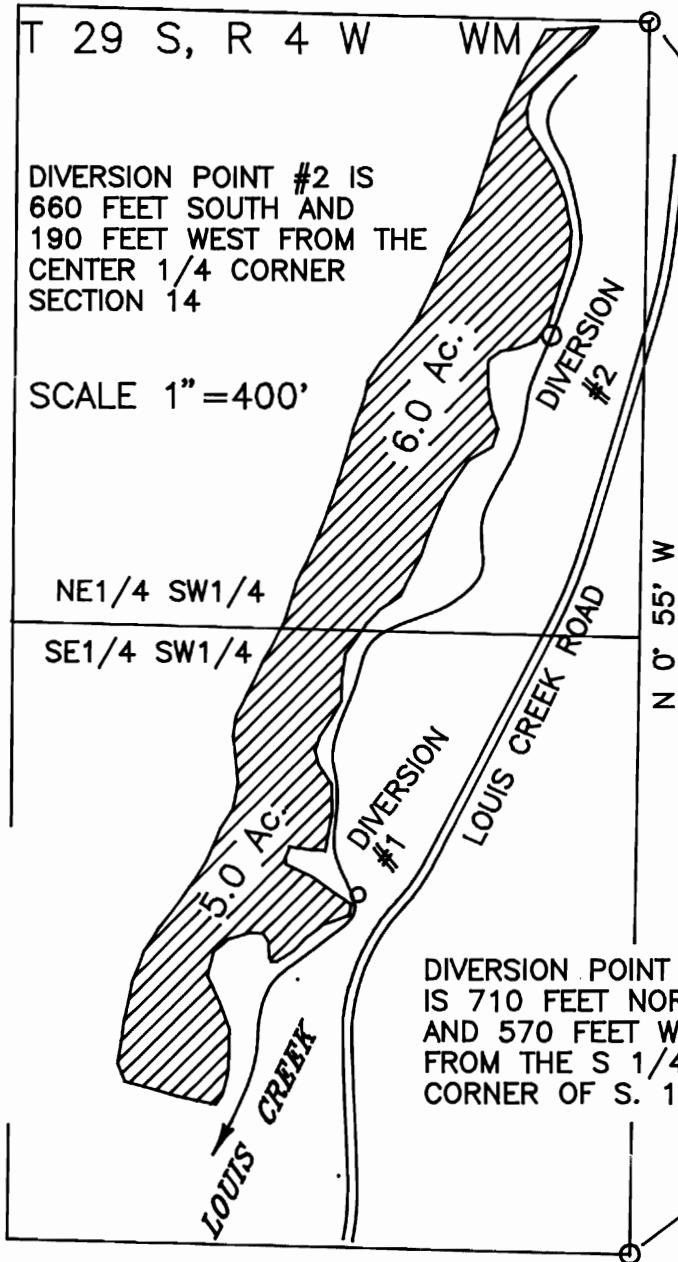

MAP TO ACCOMPANY FINAL PROOF SURVEY

TRANSFER No. 7455

IN NAME OF

Vera Pruett

DATE OCTOBER 6, 1996

BY: WILLIAM J. RUPPERT
P.O. BOX 1564
MYRTLE CREEK, OR 97457

