
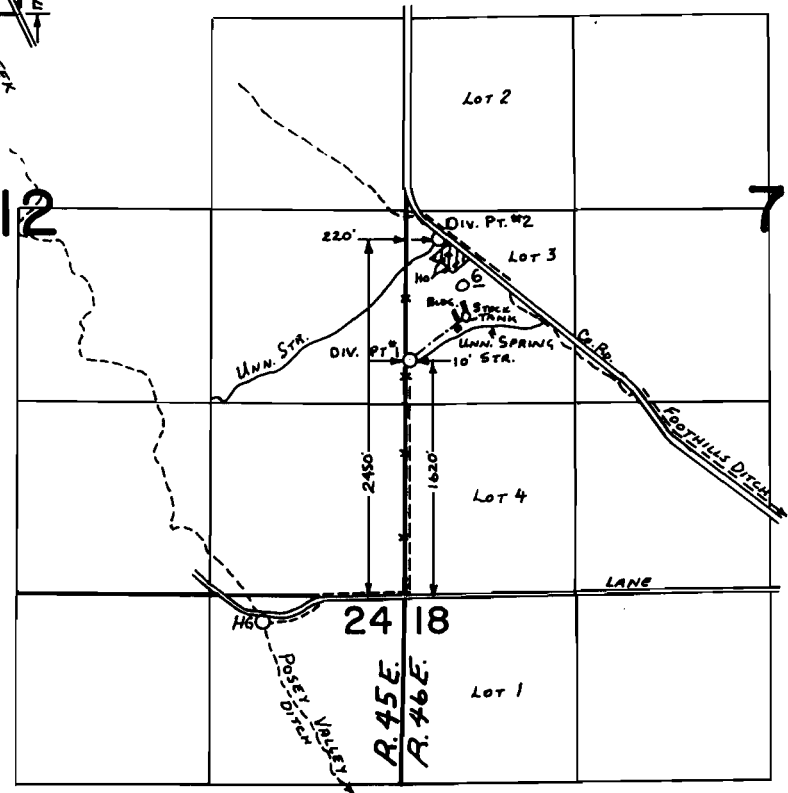


# T.8S.,R.46E.,W.M.

T.7S.,R.45E.,W.M.  
SEC. 15

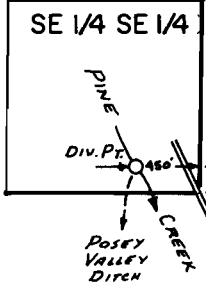

SCALE: 1" = 1320'

## FINAL PROOF SURVEY UNDER

Transfer No. 4021  
57783  
Application No. 59315... Permit No. 43660  
44620.....  
IN NAME OF

ESTELLA (MRS. ORSON) SUMMERS.....

Surveyed ..Sept..24. 19.85., by ..L.M.TOLL.....