
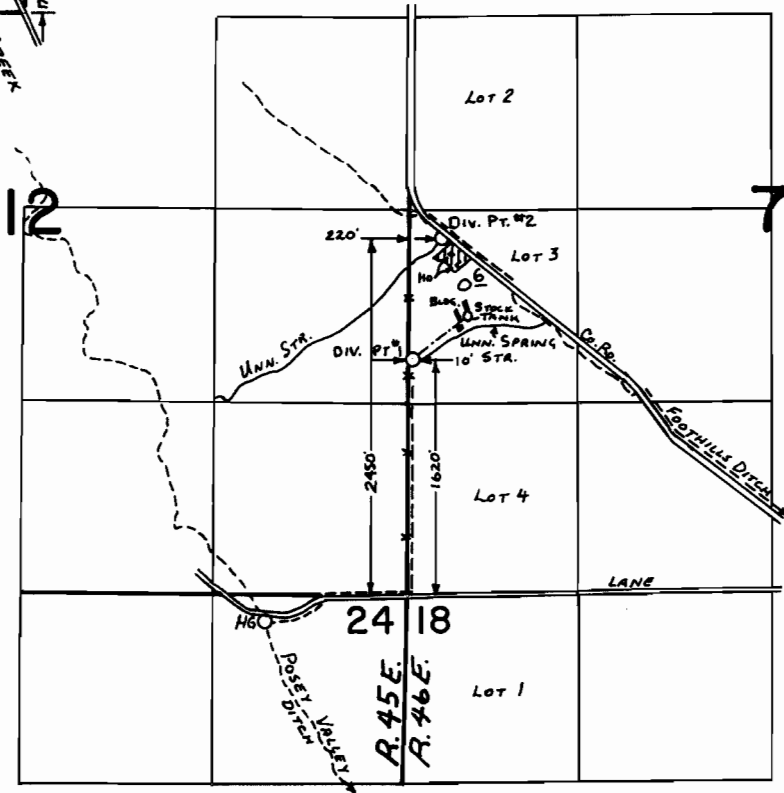
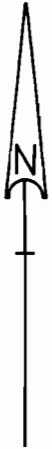


T.8S.,R.46E.,W.M.

T.7S.,R.45E.,W.M.
SEC. 15

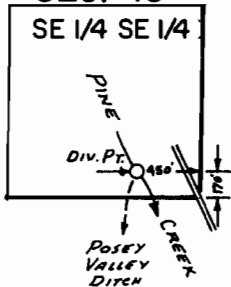

SCALE: 1" = 1320'

FINAL PROOF SURVEY
UNDER

Transfer No. 4021
57783 43660
Application No. 59315 Permit No. 44620.....
IN NAME OF

ESTELLA... (MRS... ORSON)... SUMMERS.....

Surveyed ..Sept..24. 19.85, by ..L...M...TOLL.....