


T. 3 S. R. 4 W. W.M.

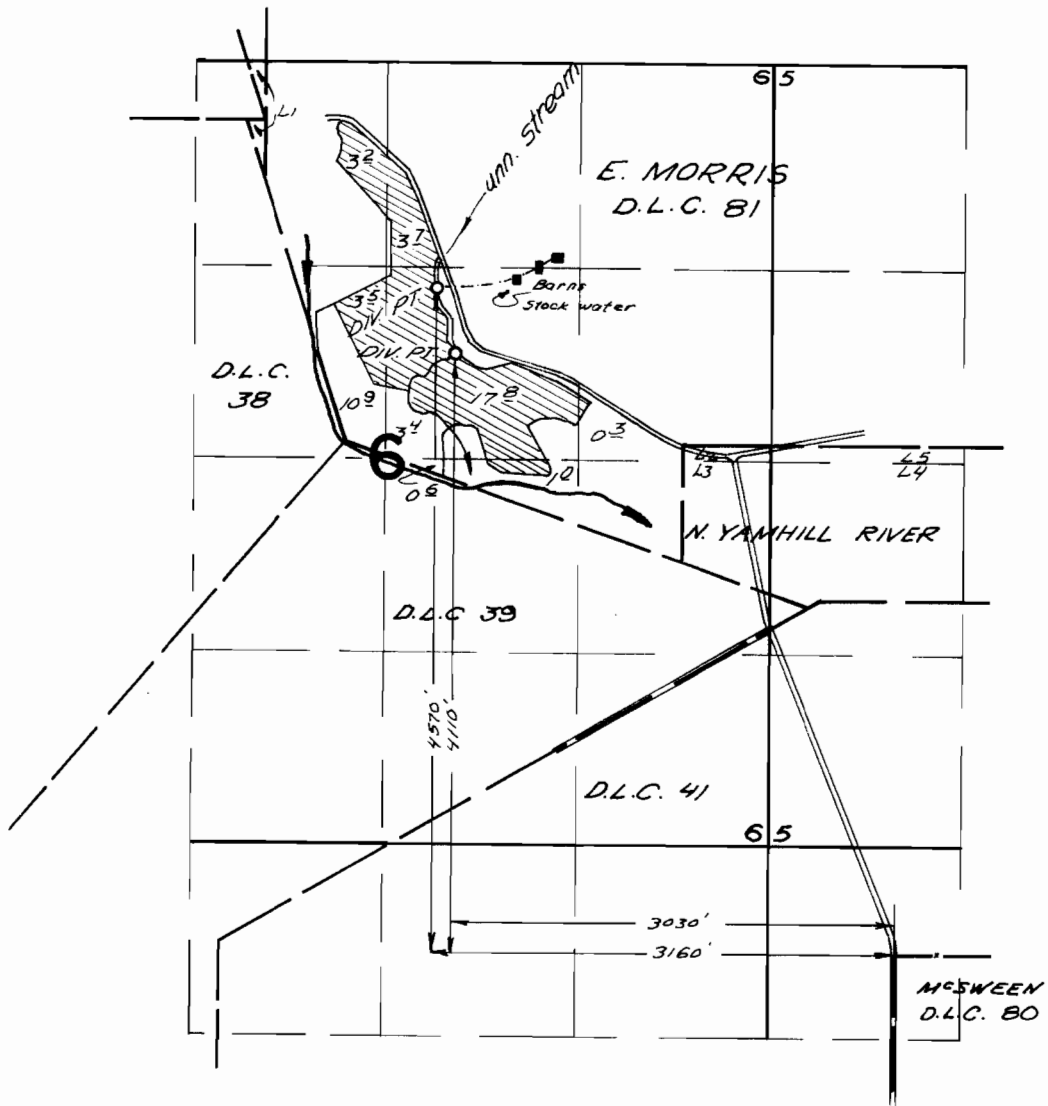

FINAL PROOF SURVEY UNDER

Application No. 38384. Permit No. 28705.
IN NAME OF

..... LEO R. MORRIS

Surveyed Oct. 19, 1967, by V. Garner.....