


T. 9 S., R. 25 E., W. M.

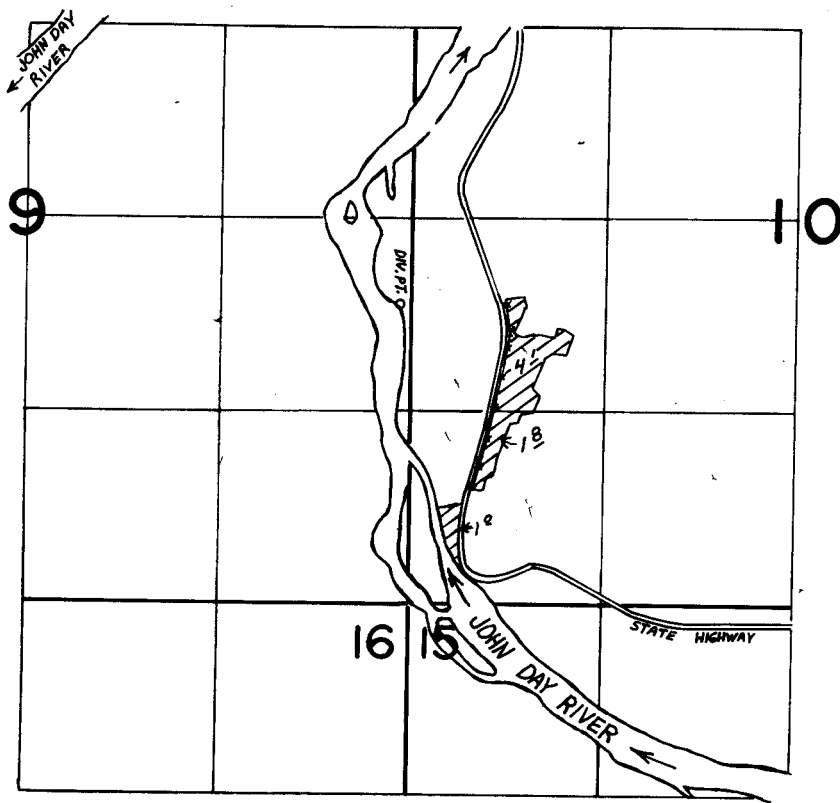

SCALE: 1" = 1320'



DIV. PT. LOCATED 600' S. & 60' W. FROM E. 1/4 COR. SEC. 9

FINAL PROOF SURVEY UNDER

Application No. 59736. Permit No. 45209.....
IN NAME OF

JAMES G. DOHERTY

Surveyed APRIL 9, 1985., by V.L. CHURCH.....