

Scale: 1" = 400 ft.
(Assessor's map scale)


Point of diversion is 500 feet South
& 1,640 feet West of the northeast
corner of Section 13.

**FINAL PROOF SURVEY OF A
PERMIT TO APPROPRIATE SURFACE WATER
IN THE NW 1/4 NE 1/4 OF SECTION 13,
T30S, R5W 8 THE N 1/2 NW 1/4, SECTION 18,
T30S, R4W, W.M., DOUGLAS COUNTY,
OREGON**

**Application No. 65324
Permit No. 47933**

For: Joann Sandstede, Jean C. Bradley &
Donna J. Clough
135 W. Berdine St.
Roseburg, Oregon 97470

By: Shaner Engineering, Inc.
P.O. Box 1430
Roseburg, Oregon 97470

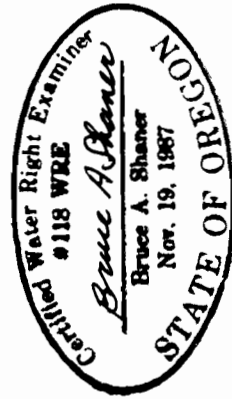

RECEIVED
AUG 18 1998

July 31, 1998