


T. 3 S., R. 3 W. WM.

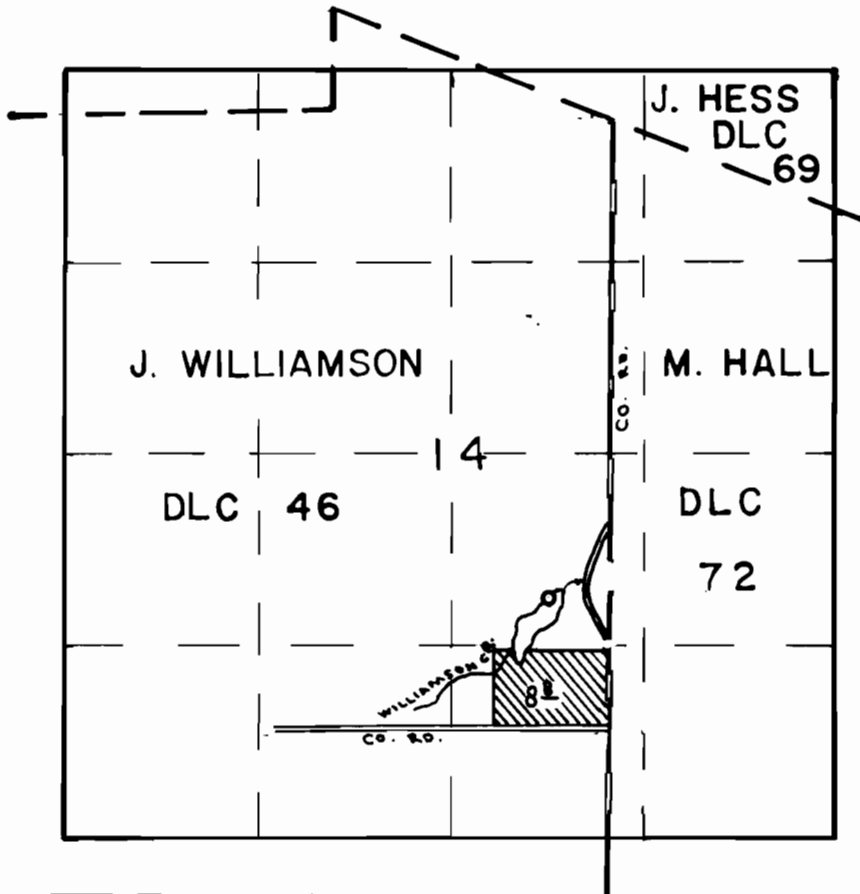

DIV. PT. LOC.: 2030' N. & 450' W. OF SE COR. DLC 46

FINAL PROOF SURVEY
UNDER

TRANSFER 4859
IN NAME OF

HERRING BROS.

Surveyed JUL 12 1984, by P. PAGTER