


T27S, R6W, WM

SCALE 1" = 1320'

DOUGLAS COUNTY

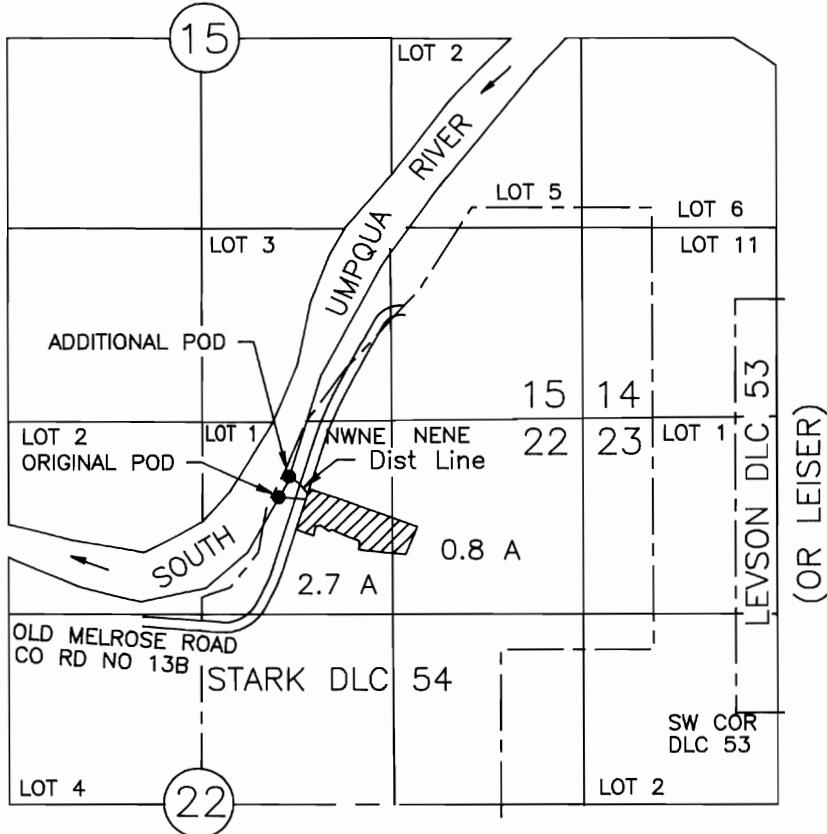

ORIGINAL POD IS 1560 FT N AND 3090 FT W FROM SW COR LEVSON DLC 53
ADDITIONAL POD IS 1705 FT N AND 3020 FT W FROM SW COR LEVSON DLC 53

FINAL PROOF SURVEY UNDER

Mary Ann Tarvers
PO Box 523
Roseburg, OR 97470

Transfer No. T-6927 Permit No. 30697 Certificate No. 51849

IN NAME OF
MARY ANN TARVERS

Surveyed March 14, 1998 by M E Farr

THIS IS A LOCATION MAP FOR A FINAL PROOF SURVEY
BY MARY ANN TARVERS. THIS MAP IS FOR THE PURPOSE
OF IDENTIFYING THE LOCATION OF THE WATER RIGHT ONLY
AND IS NOT INTENDED TO PROVIDE LEGAL DIMENSIONS
OR LOCATION OF PROPERTY OWNERSHIP LINES.

