

T. 26 S., R. 15 E., W.M.

# FINAL PROOF SURVEY


UNDER  
APPLICATION NO. G-9126 PERMIT NO. G-8551  
IN NAME OF

 PRIMARY  
 SUPPLEMENTAL

THEODORE R. TIAHRT OF DOUBLE TREE RANCH

SURVEYED AUG 24, 1993, BY R.M. SUTTERFIELD

SCALE: 1" = 660'

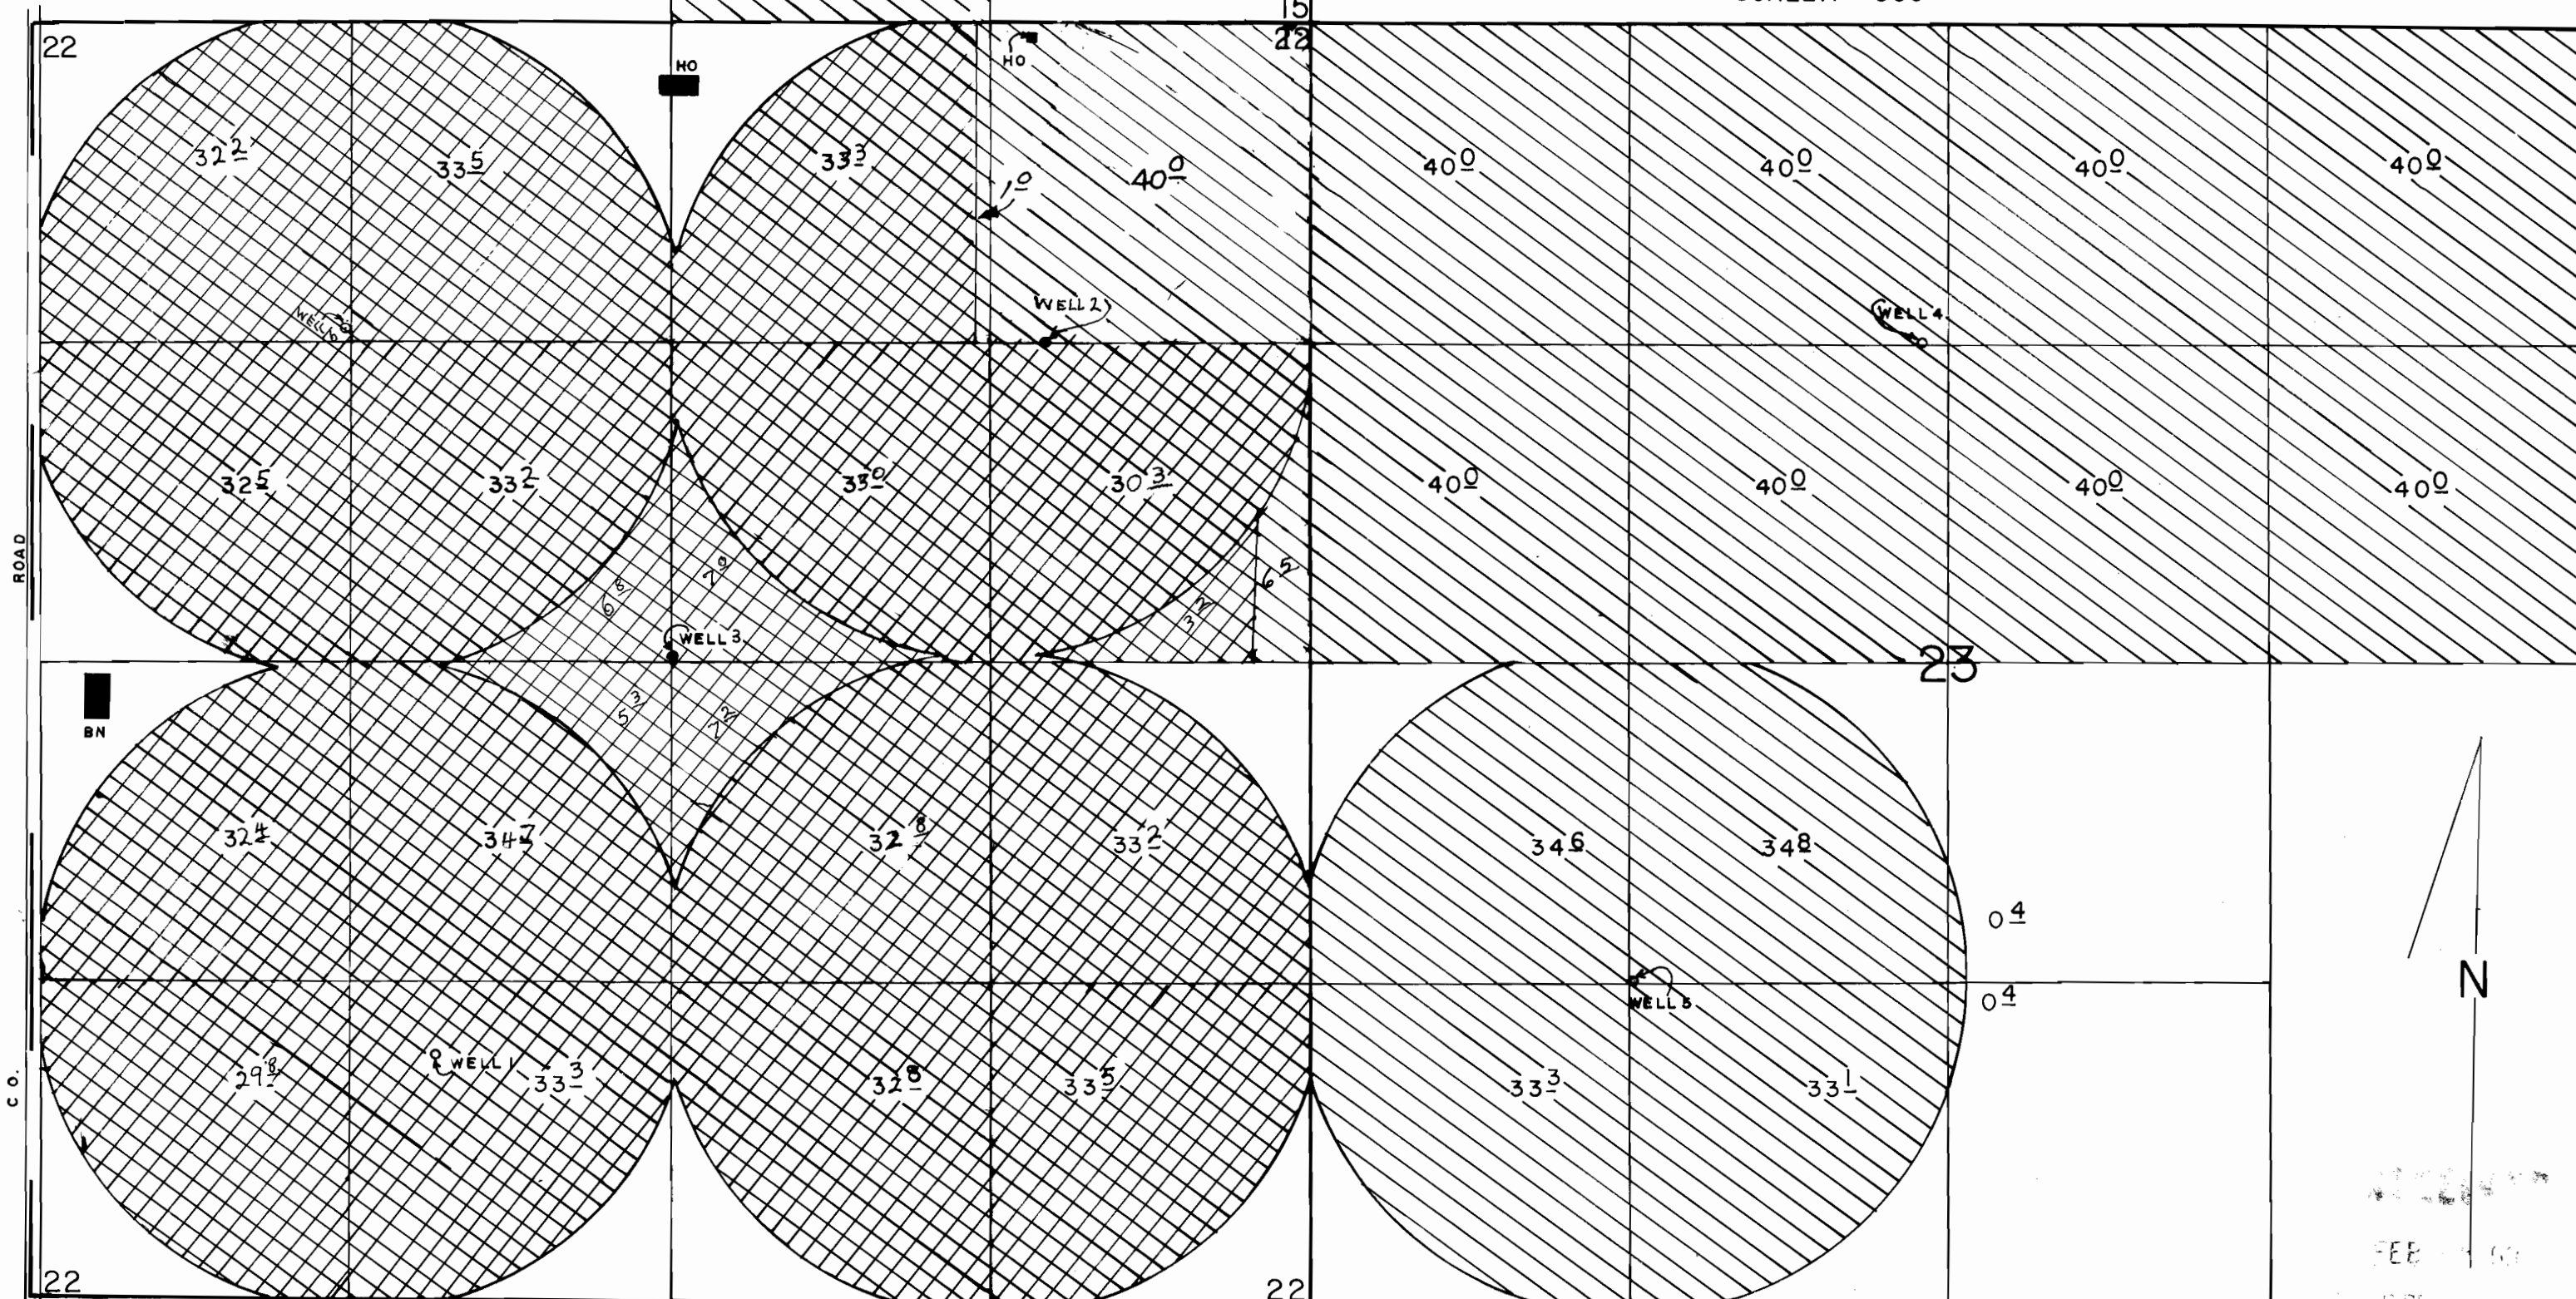

WELL 1 LOC: 1120' N & 1650' E FROM SW COR. OF SEC 22.  
 WELL 2 LOC: 1300' S & 1130' W FROM NE COR. OF SEC 22.  
 WELL 3 LOC: 2560' N & 2725' E FROM SW COR. OF SEC 22.

WELL 4 LOC: 1310' S & 2530' E FROM NW COR. OF SEC 23.  
 WELL 5 LOC: 1330' N & 1330' E FROM SW COR. OF SEC 23.  
 WELL 6 LOC: 2620' S & 2630' W FROM NE COR. OF SEC 22.

FEB 1994  
 RESURVEYED  
 A.M.