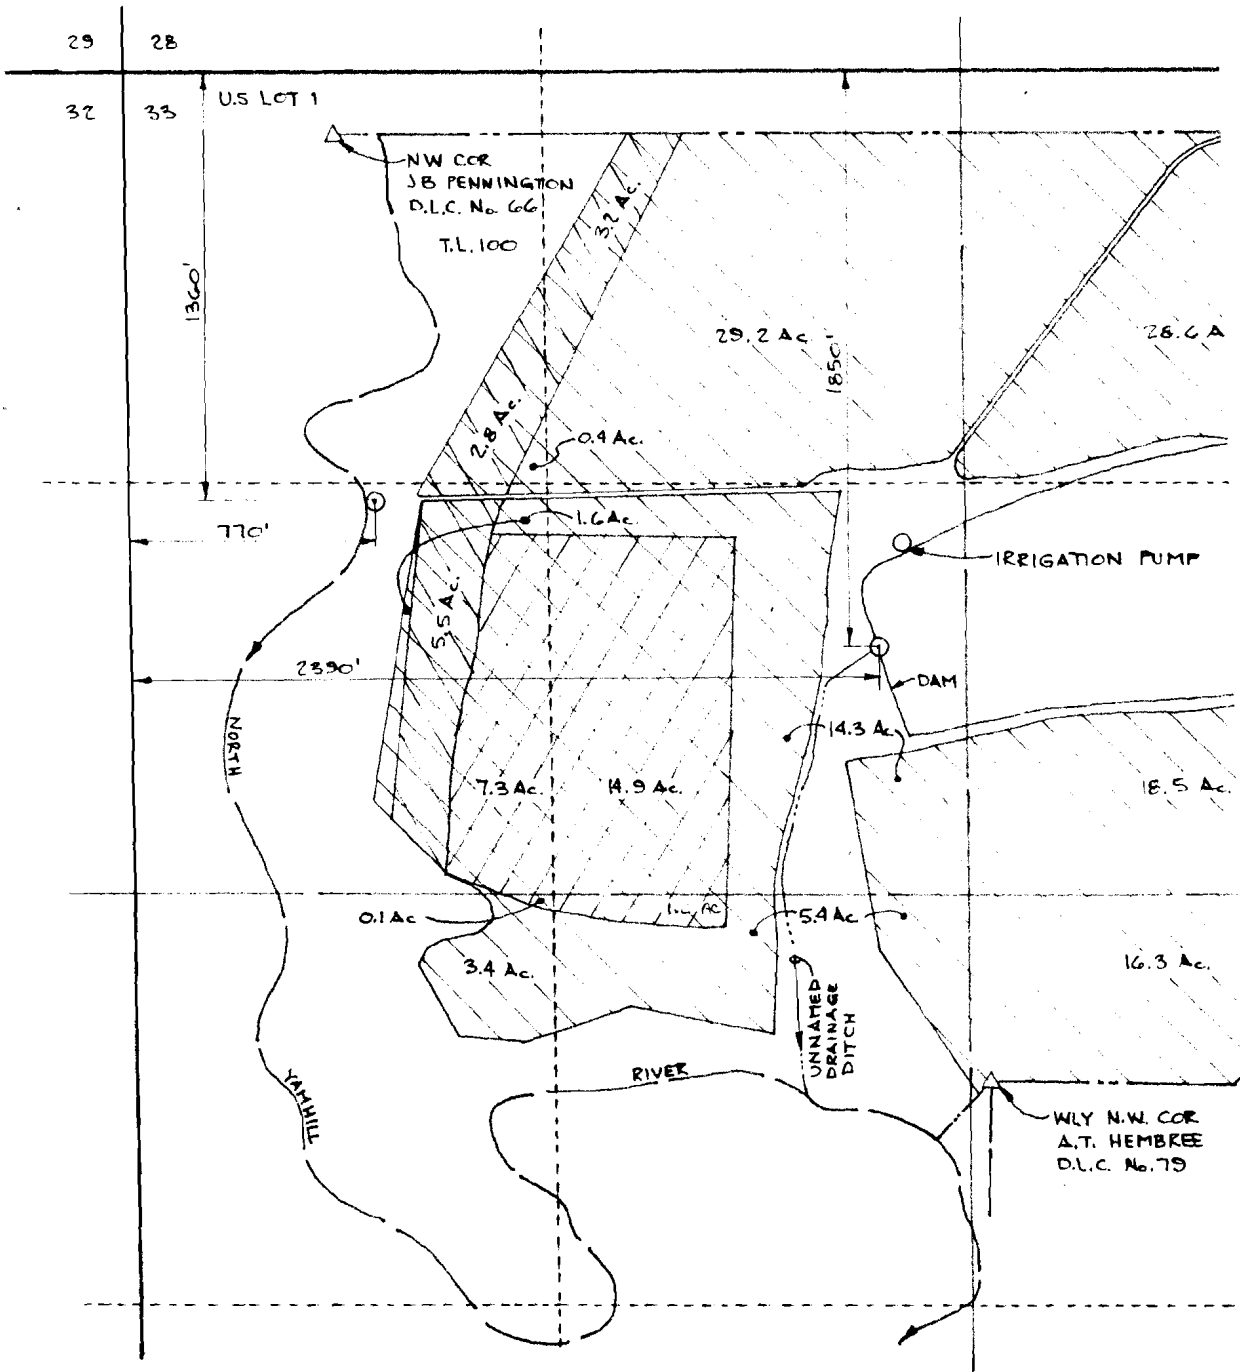


SECTION 33 & 34, T.3S.,  
YAMHILL COUNTY, OR

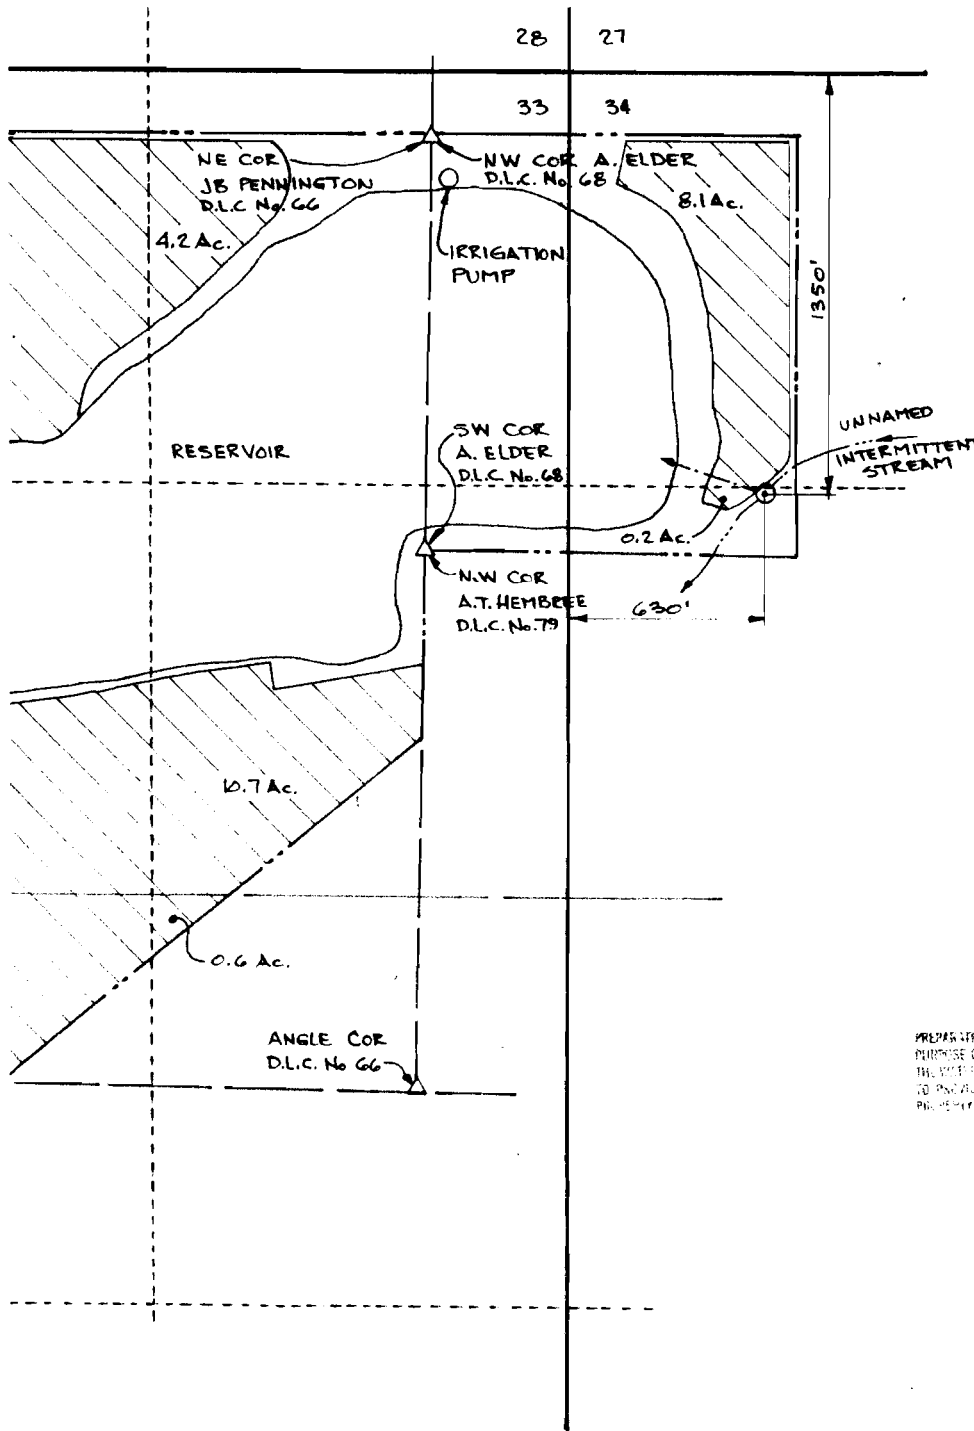


FINAL PROC  
UNDER  
APPLICATIONS  
PERMITS  
SURVEYED

**VERBOORT ENGINEERING**

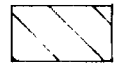
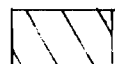
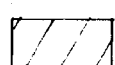
AGRICULTURE · CIVIL · WATER RESOURCES

	by	date
designed	WKV	9-8-98
drawn	JER	9-8-98



SCALE: 1"=400'

MAP BASE:  
COUNTY ASSESSORS P  
1998 WAC SCALED PHOTO

-  PERMIT R-11492  
PERMIT -51527
-  CERT. 57609
-  CERT. 57610


OF SURVEY  
R  
R-73260, 73261  
R-11492, 51527  
8-27-98



BAILEY NURSERIES, INC.  
9855 N.W. PIKE RD.  
YAMHILL, OR 97148