

CLAIM OF BENEFICIAL USE FINAL PROOF MAP

Located in the NE1/4 SE1/4 of Section 4
Township 23 South, Range 12 West, W.M.
Coos County, Oregon
Application S-76179 Permit 52654

Prepared For: Robert W. Shank
Prepared By: Dennis Goude
Date Prepared: September 13, 1999


NOTE:
The P.O.D. is an intake 1/2 HP submersible pump and is located 707 feet South and 894 feet West from the East 1/4 corner of Section 4.



EXPIRES 06/30/2001

LEGEND
P.O.B. ●
P.O.D. —
PIPE —

Scale 1" = 100 Feet
Assessors Scale

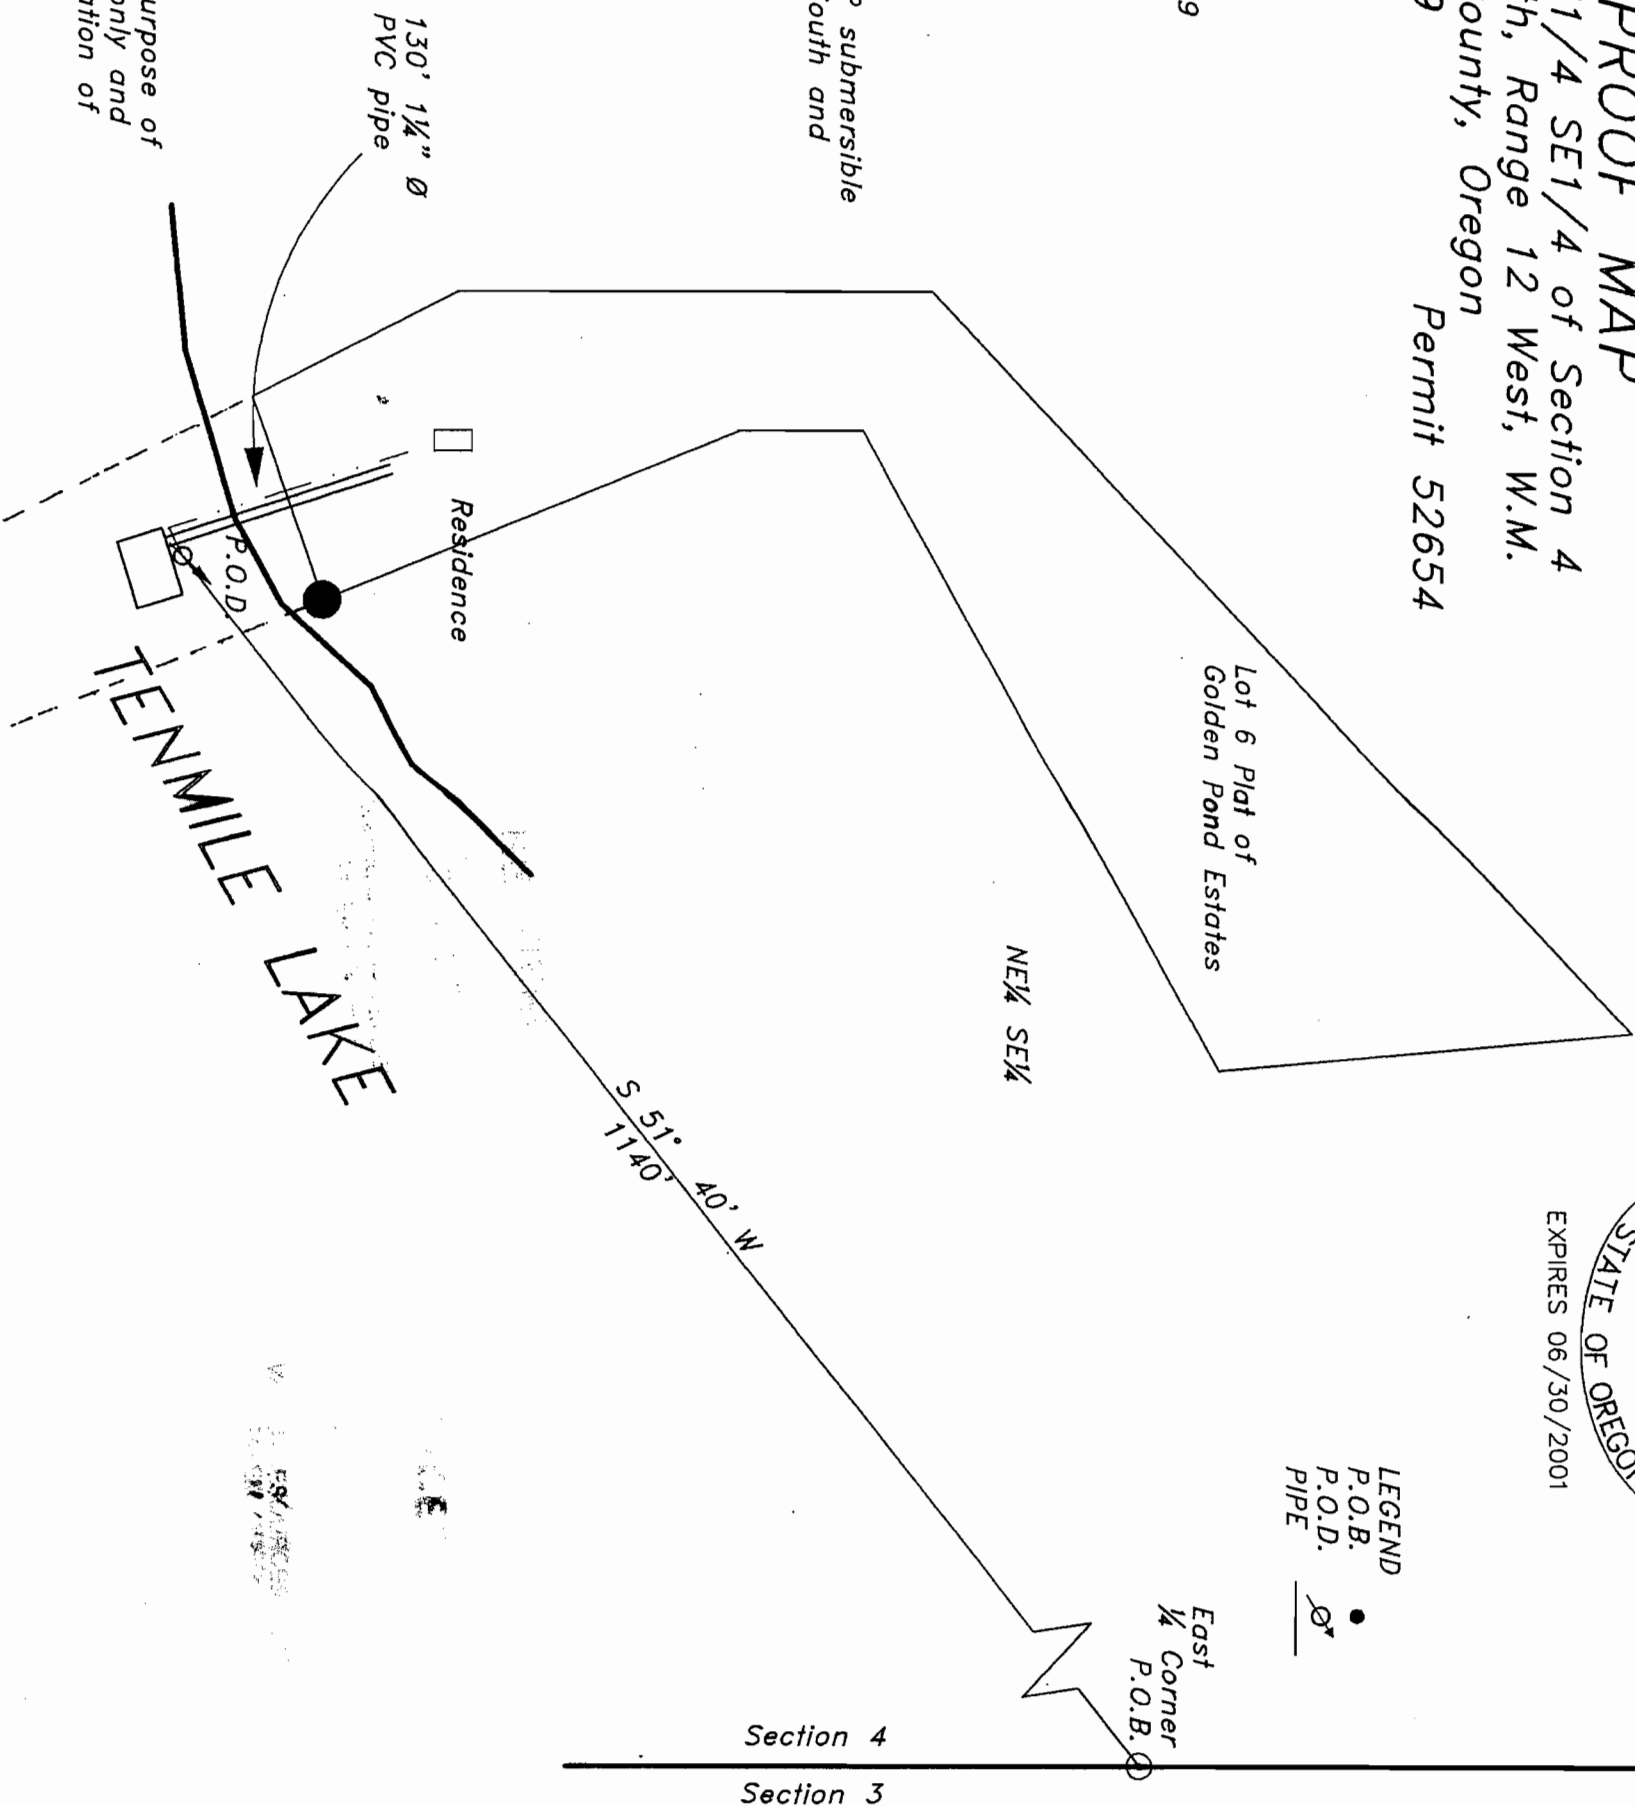

EXAMINERS DISCLAIMER STATEMENT
The preparation of this map was for the purpose of identifying the location of the Water Right only and has no intent to provide dimensions or location of property ownership lines.

Stuntzner Engineering
& Forestry, L.L.C.
ENGINEERING • LAND SURVEYING • FORESTRY
PLANNING • WATER RIGHTS
706 South 4th St.
Post Office Box 118
Coos Bay, Oregon 97420
Phone: (541) 267-2872
Fax: (541) 267-0688