


T. 6 & 7 S. R. I W. W. M.

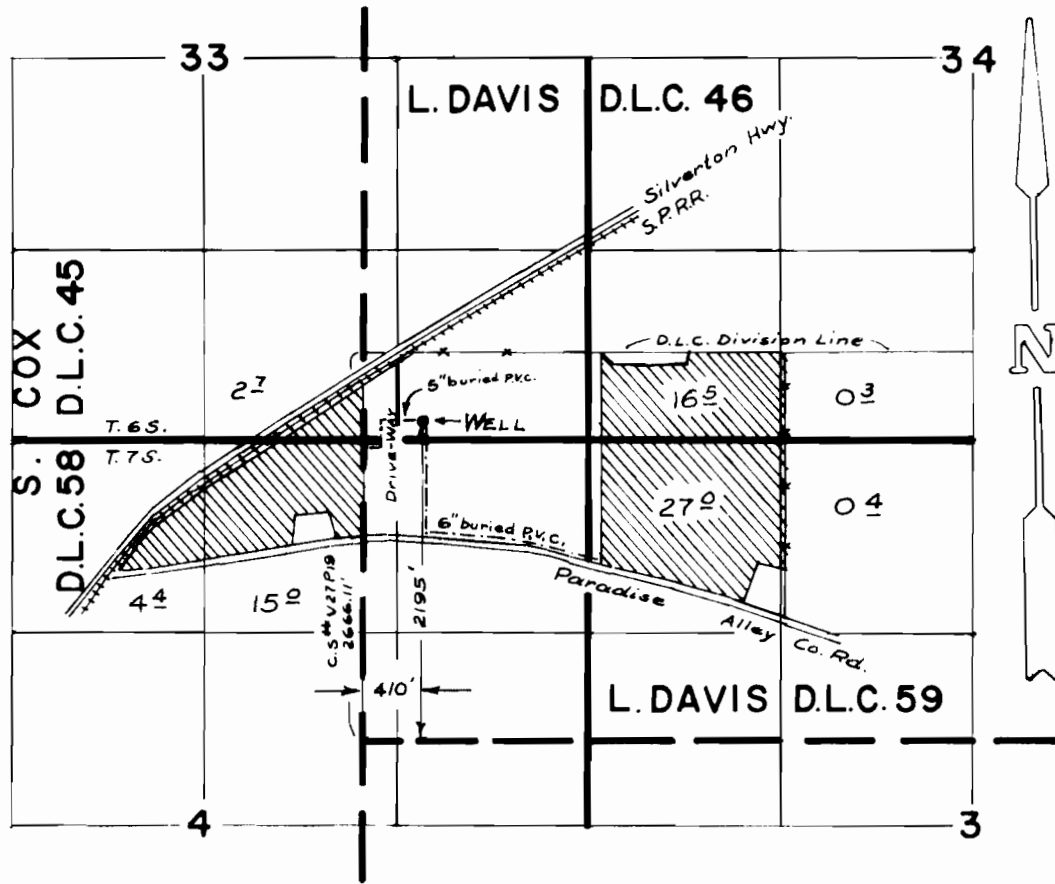

Scale: 1" = 1320'

CLAIM OF BENEFICIAL USE

UNDER APPLIC. No. G-11727 PER. No. G-10813

IN NAME OF

COOLEY'S GARDENS, INC.

THE PREPARATION OF THIS MAP IS FOR THE PURPOSE OF IDENTIFYING THE LOCATION OF THE WATER RIGHT ONLY AND HAS NO INTENT TO PROVIDE DIMENSIONS OR LOCATION OF PROPERTY OWNERSHIP LINES.

