


T. 24 S., R. 7 W., W.M.

~~XXXXXXXXXX~~
~~XXXXXXXXXX~~
~~XXXXXXXXXX~~

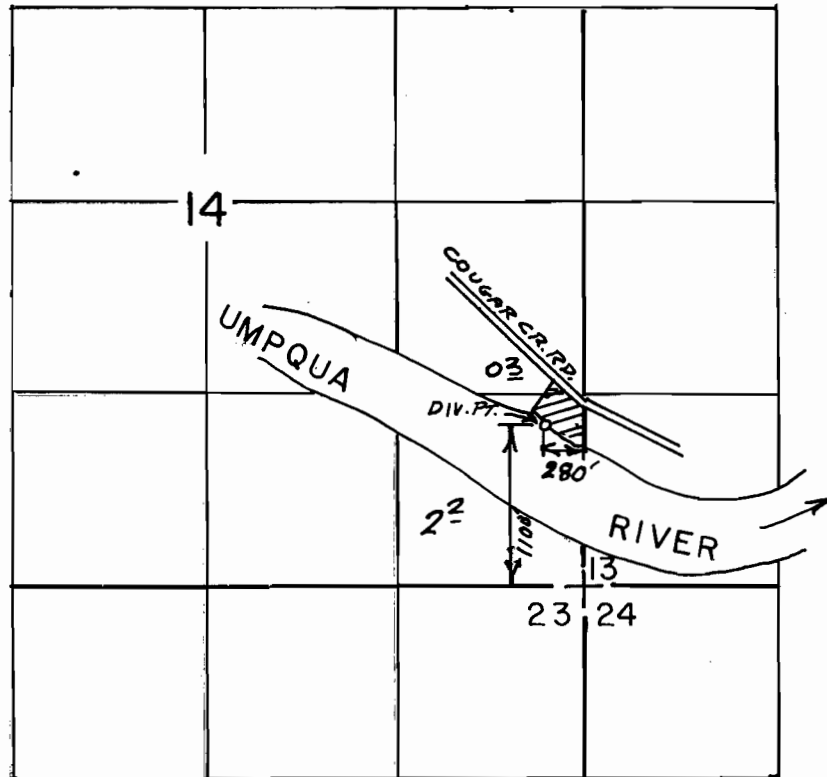

Scale 1" = 1320'

FINAL PROOF SURVEY
UNDER

Application No. 691.72. Permit No. 500.83...
IN NAME OF

RUDOLPH W. & ELIZABETH H. A. ZIEGLER

Surveyed April 11, 1996, by S. JAMES.....