


G-8197

53853  
76467  
T 8330

# T.26S.,R.18E.,W.M.

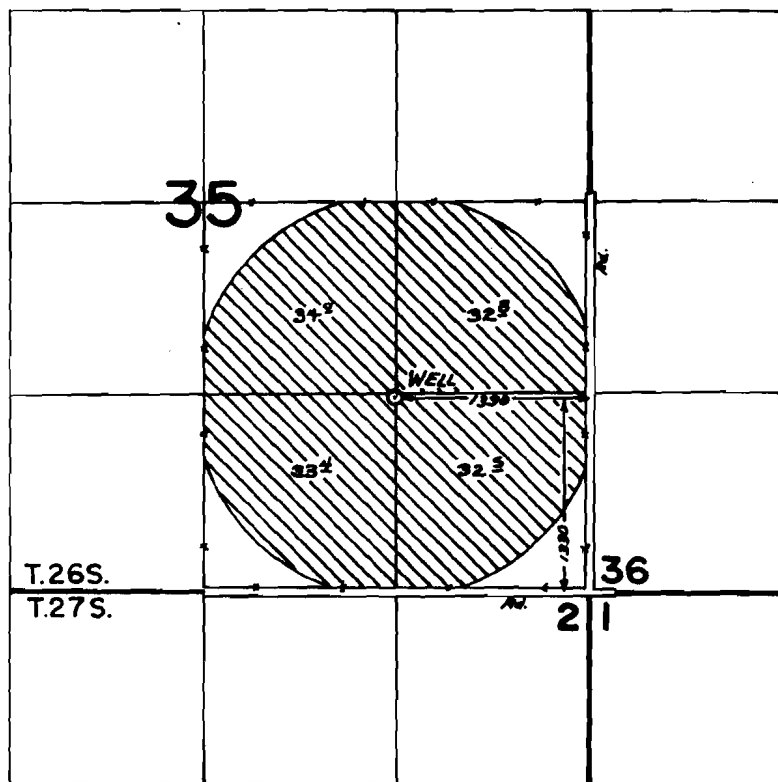

## FINAL PROOF SURVEY UNDER

Application No. G-8749 Permit No. G-8197  
IN NAME OF

FLOWERREE FARMS, INC.

Surveyed OCT. 24. 19.81., by L. TOLL.