


G-9020

57229  
75845  
T8045  
76468  
T8330

# T.27S., R.19E., W.M.

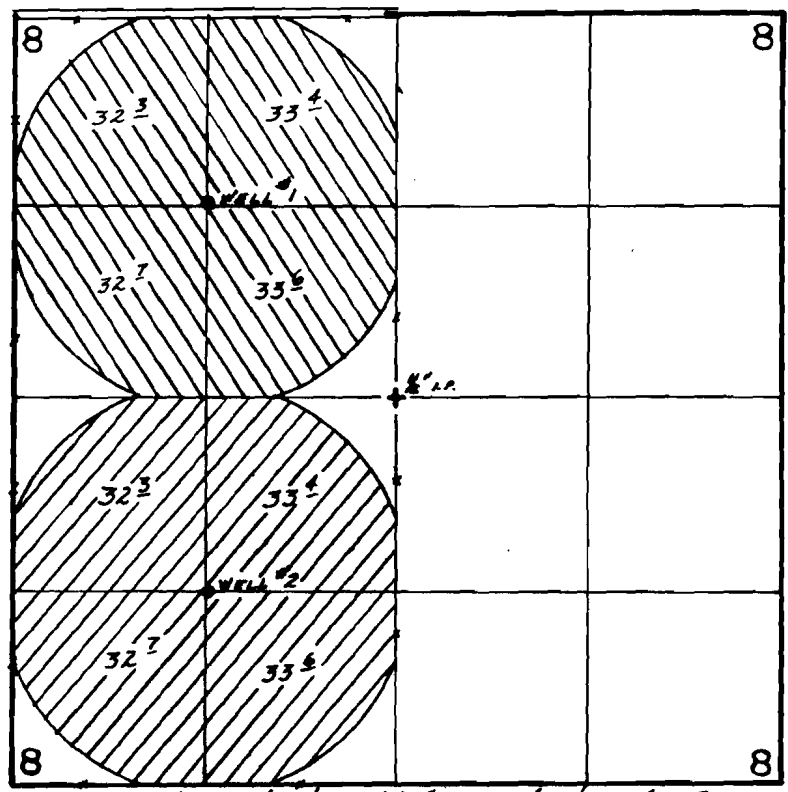

WELLS LOC.: #1-1340' N. & 1320' W., #2-1320' S. & 1300' W., BOTH FROM C 1/4 COR. SEC. 8.

 Well #1  
 Well #2

SCALE: 1" = 1320'

## FINAL PROOF SURVEY UNDER

Application No. G-9781. Permit No. G-9020...  
IN NAME OF

.....FLOWEREE FARMS, INC.....

Surveyed Oct. 11, 1985, by B.W. BISHOP.....

1/25/88 BWS

PTS 1985-L (EMBURO)