


G-9026

T8330
T8331
55177
76469

T.26S.,R.18E.,W.M.

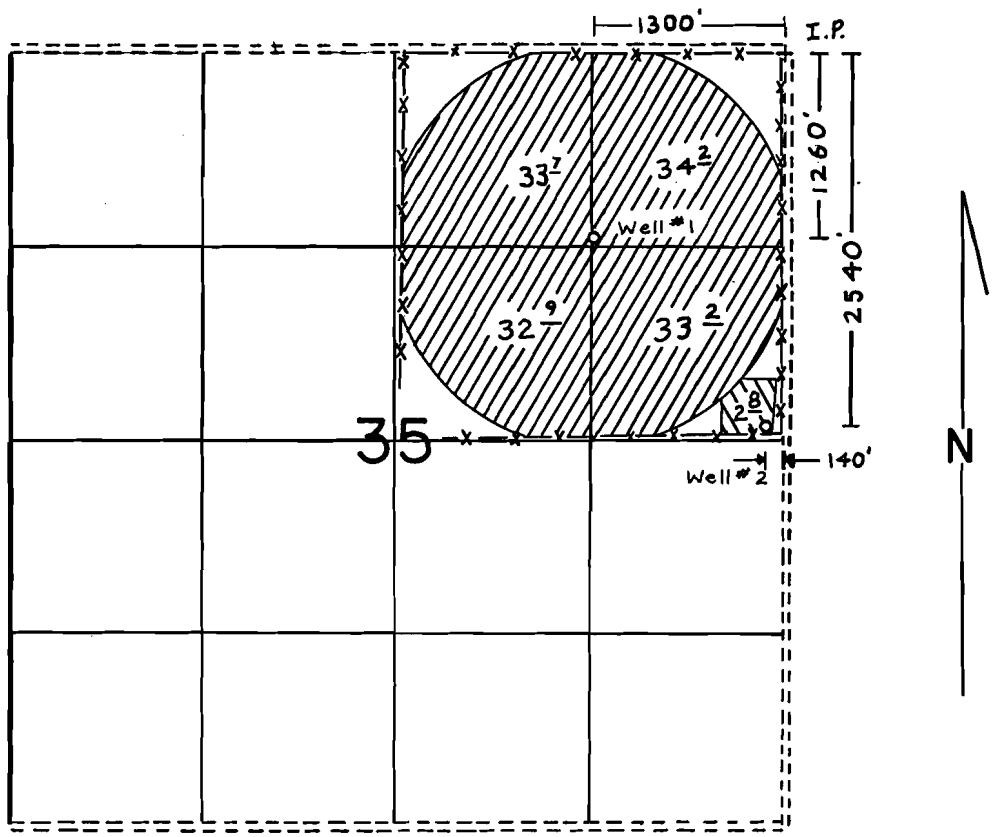

SCALE: 1" = 1320'

FINAL PROOF SURVEY
UNDER

Application No. G-9909 Permit No. G-9026....
IN NAME OF

.....FLOWERREE FARMS INC.....

Surveyed APRIL 17, 1985., by LESLIE OLSON....