


RECEIVED NW 1/4

JUN 1 6 1998

WATER RESOURCES DEPT.
SALEM, OREGON

SEE MAP 26 6 27CC

THIS MAP WAS PREPARED FOR
ASSESSMENT PURPOSE ONLY.

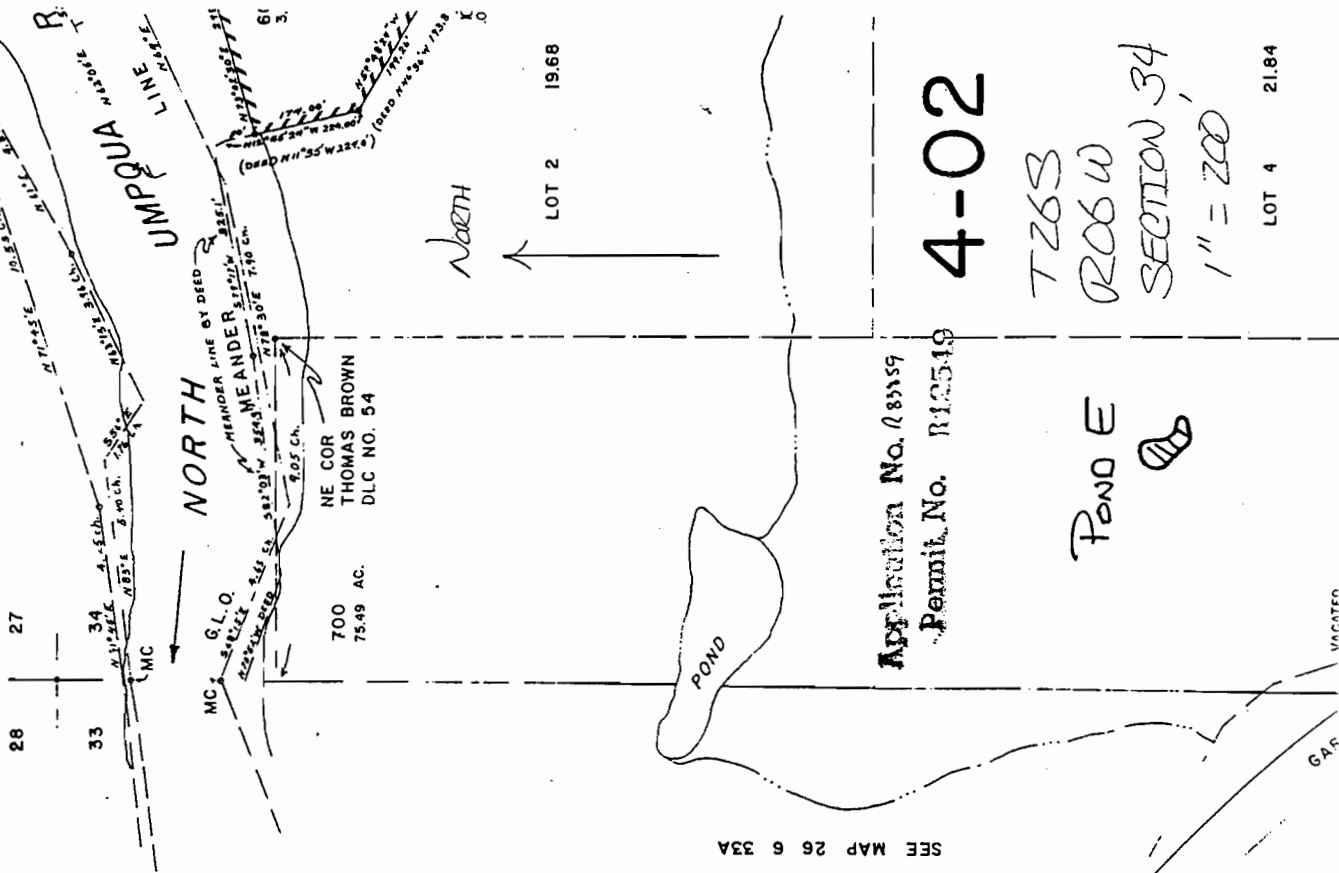

RECEIVED

AUG 1 1 1999

WATER RESOURCES DEPT.
SALEM, OREGON