


T.26S. R.3W. W.M.

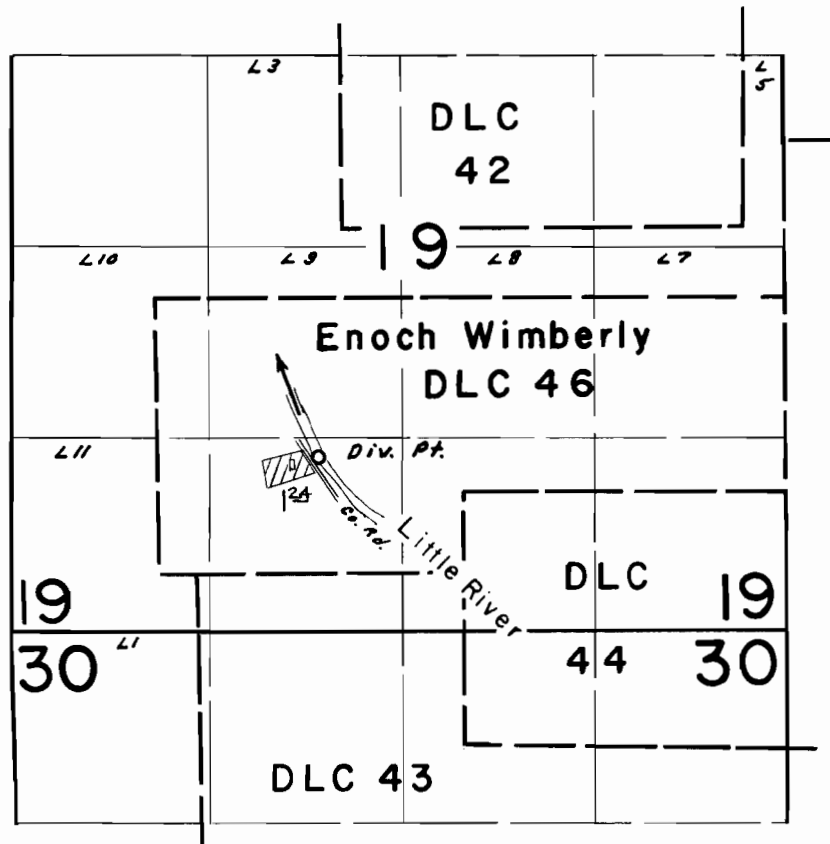

**FINAL PROOF SURVEY**  
UNDER

Application No. 38662 Permit No. 28771  
IN NAME OF

**GUSTAF & LOIS I. SCHAEFER**

Surveyed July 17, 1964, by *C. J. Anderson*