


G 2488

T8409
35641
76485
T8409

T.27S.R.16E.W.M.

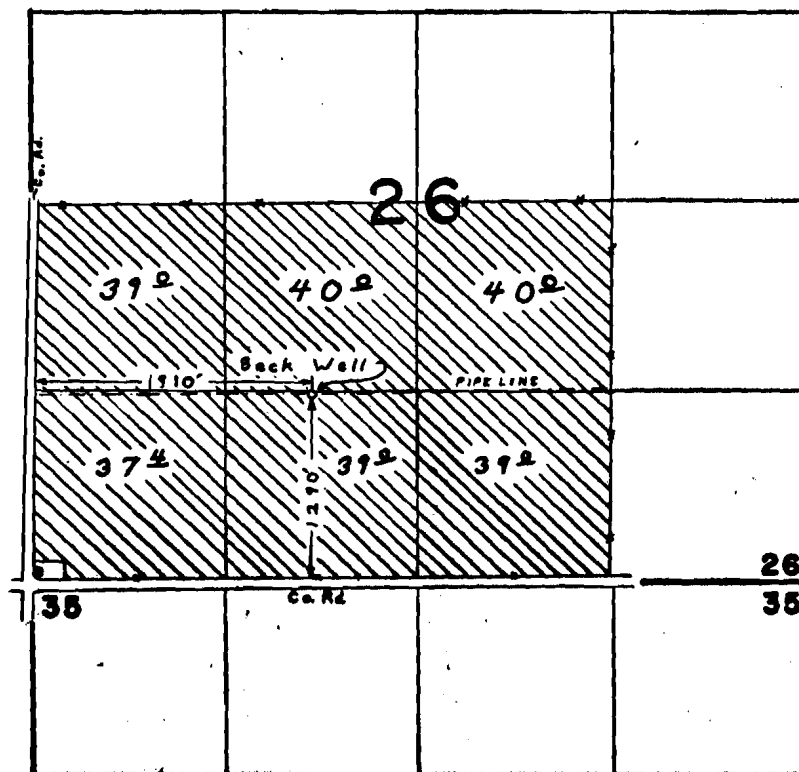

FINAL PROOF SURVEY
UNDER

Application No. G-2676. Permit No. G-2488
IN NAME OF

JOHN W. BECK

Surveyed AUG. 2... 1988, by L. E. GOULD.