




G-8649
 T8387
 65935
 75651
 75808
 76487
 T8387

T.28S., R.15E., W.M.

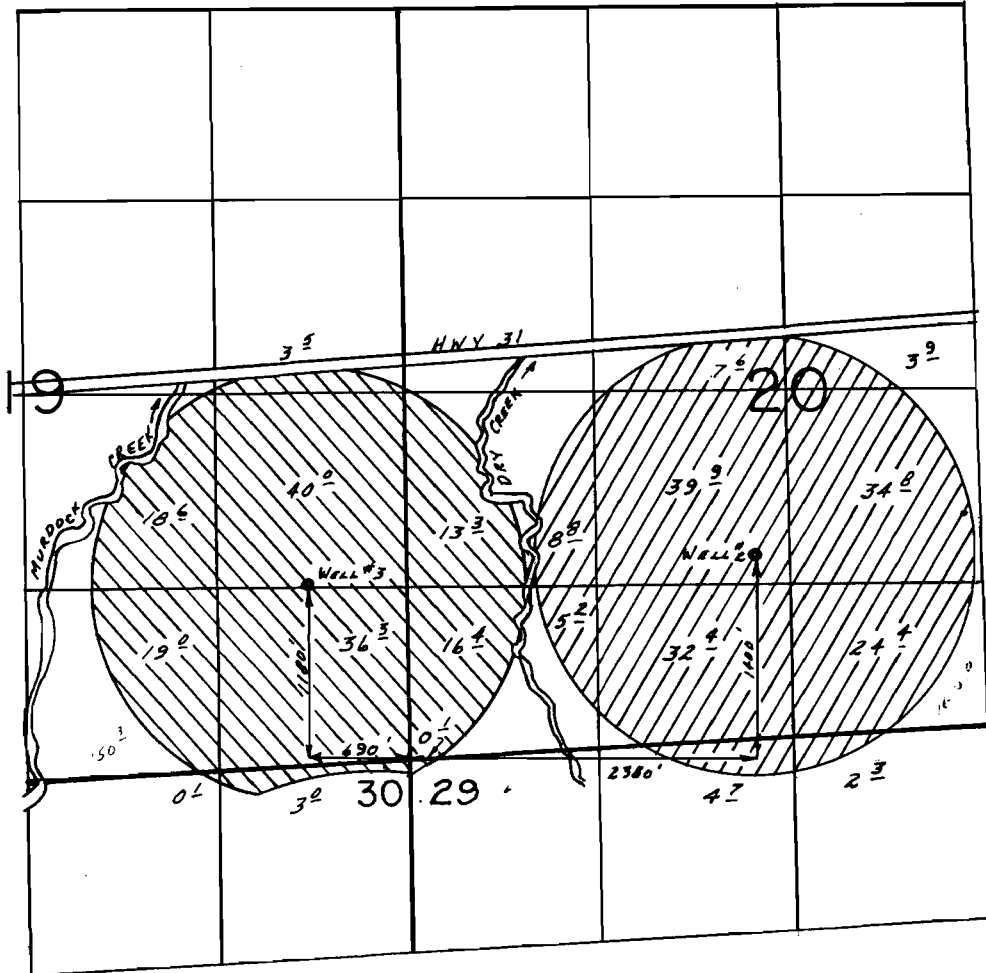

 Well 2
 Well 3

SCALE: 1" = 1320'

FINAL PROOF SURVEY
 UNDER

Application No. G-9226 Permit No. G-8649...
 IN NAME OF

.....EMERY LIVESTOCK.....

Surveyed May 14 1984, by D. GLENDER.....
 Sept. 17 1985 T.M. WARREN
 June 28 1988 B.W. BISHOP

Corrected Sect 5/16/88 sec
 1/20/89
 41037-479-618 845