





T. 7S., R. 45E., W. M.

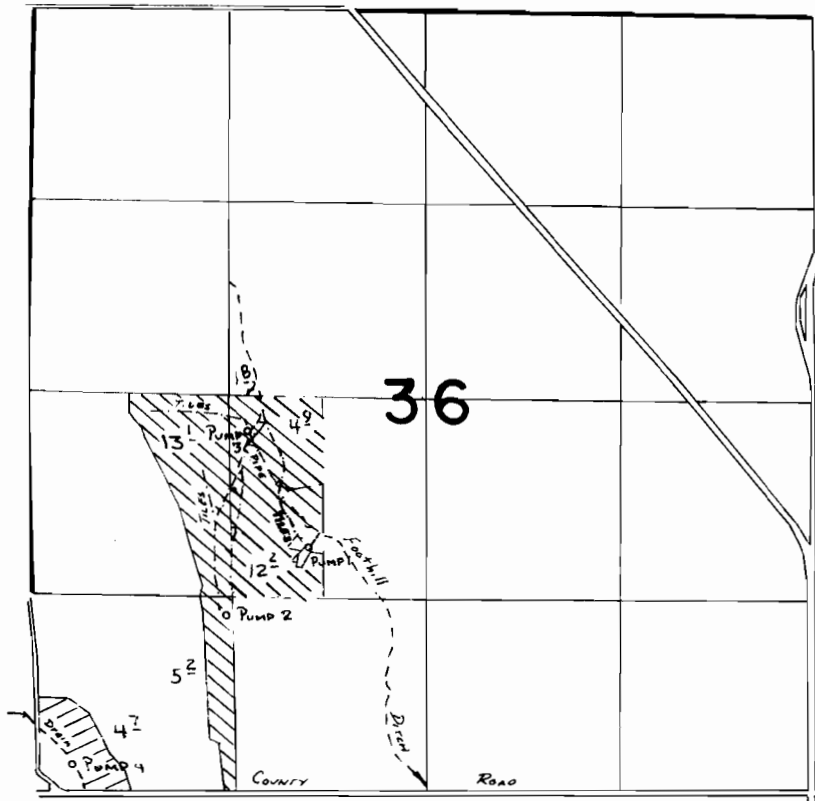

Pump 1 Loc: 1030'S. & 800'W. FROM CENTER COR. SECTION 36
 Pump 2 Loc: 1500'S. & 1370'W. FROM CENTER COR. SECTION 36
 Pump 3 Loc: 240'S. & 1220'W. FROM CENTER COR. SECTION 36
 Pump 4 Loc: 2560'S. & 2440'W. FROM CENTER COR. SECTION 36

-  PUMPS 1, 2, 3
-  PUMP 4

FINAL PROOF SURVEY
 UNDER


 SCALE: 1" = 1320'

Application No. **G:8537** Permit No. **G:7882**
 IN NAME OF

LOUISE W. SLY

Surveyed ..8-1..... 1984., by *V.L. Church*.....