


T. 30 S., R. 5 W., W. M.

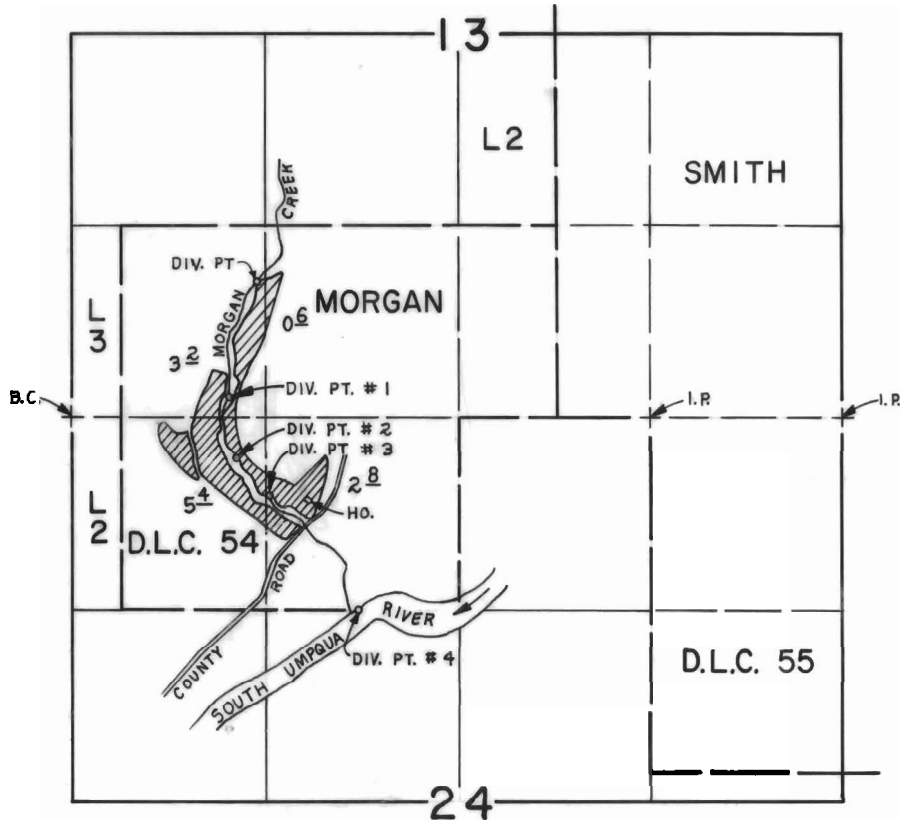

DIV. PT. #1 LOCATED 140' N. & 1,075' E. FROM N.W. COR. SEC. 24
 DIV. PT. #2 LOCATED 285' S. & 1,115' E. FROM N.W. COR. SEC. 24
 DIV. PT. #3 LOCATED 535' S. & 1,350' E. FROM N.W. COR. SEC. 24
 DIV. PT. #4 LOCATED 1,315' S. & 1,960' E. FROM N.W. COR. SEC. 24

SCALE: 4" = 1 mile

FINAL PROOF SURVEY UNDER

Application No. 57998.. Permit No. 43691.....
 IN NAME OF

.....IDA PAT EGGERT.....

Surveyed JUNE..25,1984., by L....CASHION....