


T 17 S, R 2 W, W.M.

THE PURPOSE OF THIS MAP IS TO IDENTIFY THE LOCATION OF THE WATER RIGHTS. IT IS NOT INTENDED TO PROVIDE INFORMATION RELATIVE TO THE LOCATION OF PROPERTY OWNERSHIP BOUNDARY LINES.




SCALE: 1" = 400'

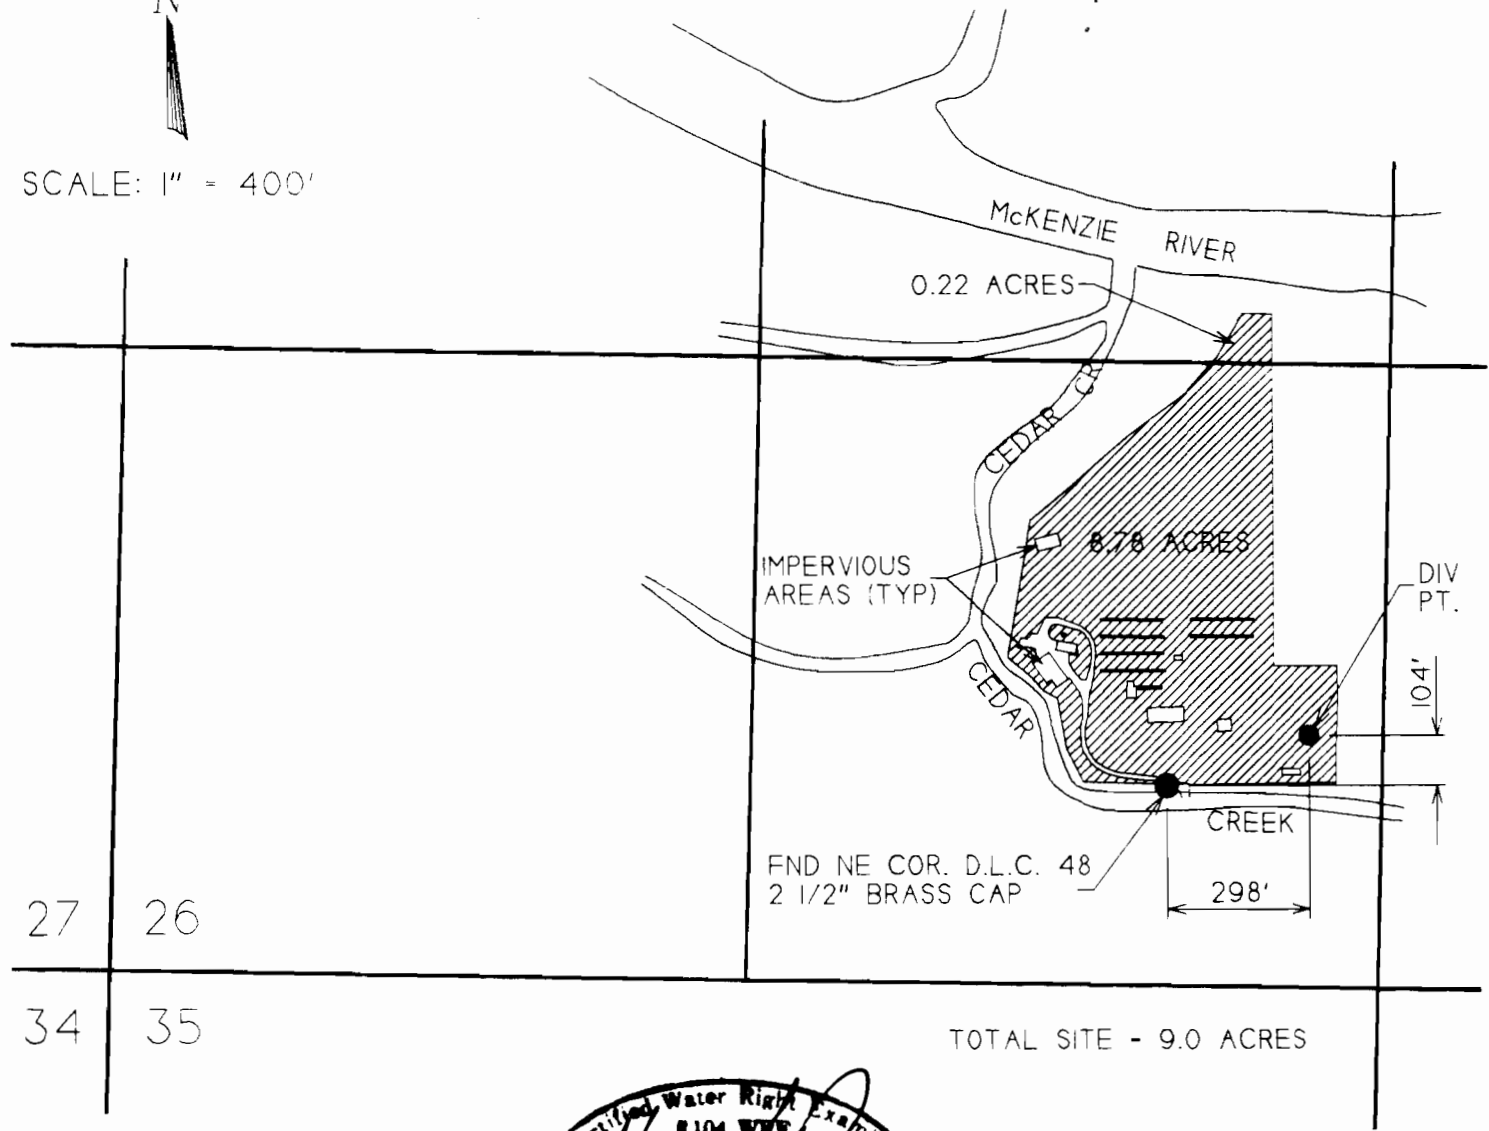

27	26
34	35

TOTAL SITE - 9.0 ACRES

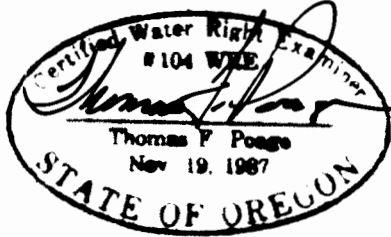

FINAL PROOF SURVEY UNDER

APPLICATION NO. G-12530 PERMIT NO. G-13125

IN THE NAME OF

MARJORY AND ROGER GOSSLER

SURVEYED NOVEMBER 7, 1997 BY RKE & RMW
CADD FILE: 1617PROF.GCD