

RECEIVED

SEP 09 1999


WATER RESOURCES DEPT.  
SALEM, OREGON

FINAL PROOF SURVEY  
UNDER PERMIT NO. G-12745

FOR  
KAREN ROWE  
LOCATED IN THE NE 1/4 OF THE NE 1/4  
OF SECTION 25, T.17S., R.14E., W.M.,  
DESCHUTES COUNTY, OREGON.


LEGEND:

-  PRIMARY IRRIGATED LAND (36 ACRES)  
COVERED BY PERMIT NO. G-12745
-  WELL #1 LOCATED 225' S. AND 562' W.  
OF NW CORNER OF SECTION 25
-  WELL #2 LOCATED 444' S. AND 585' W.  
OF NW CORNER OF SECTION 25
-  PROPERTY LINE

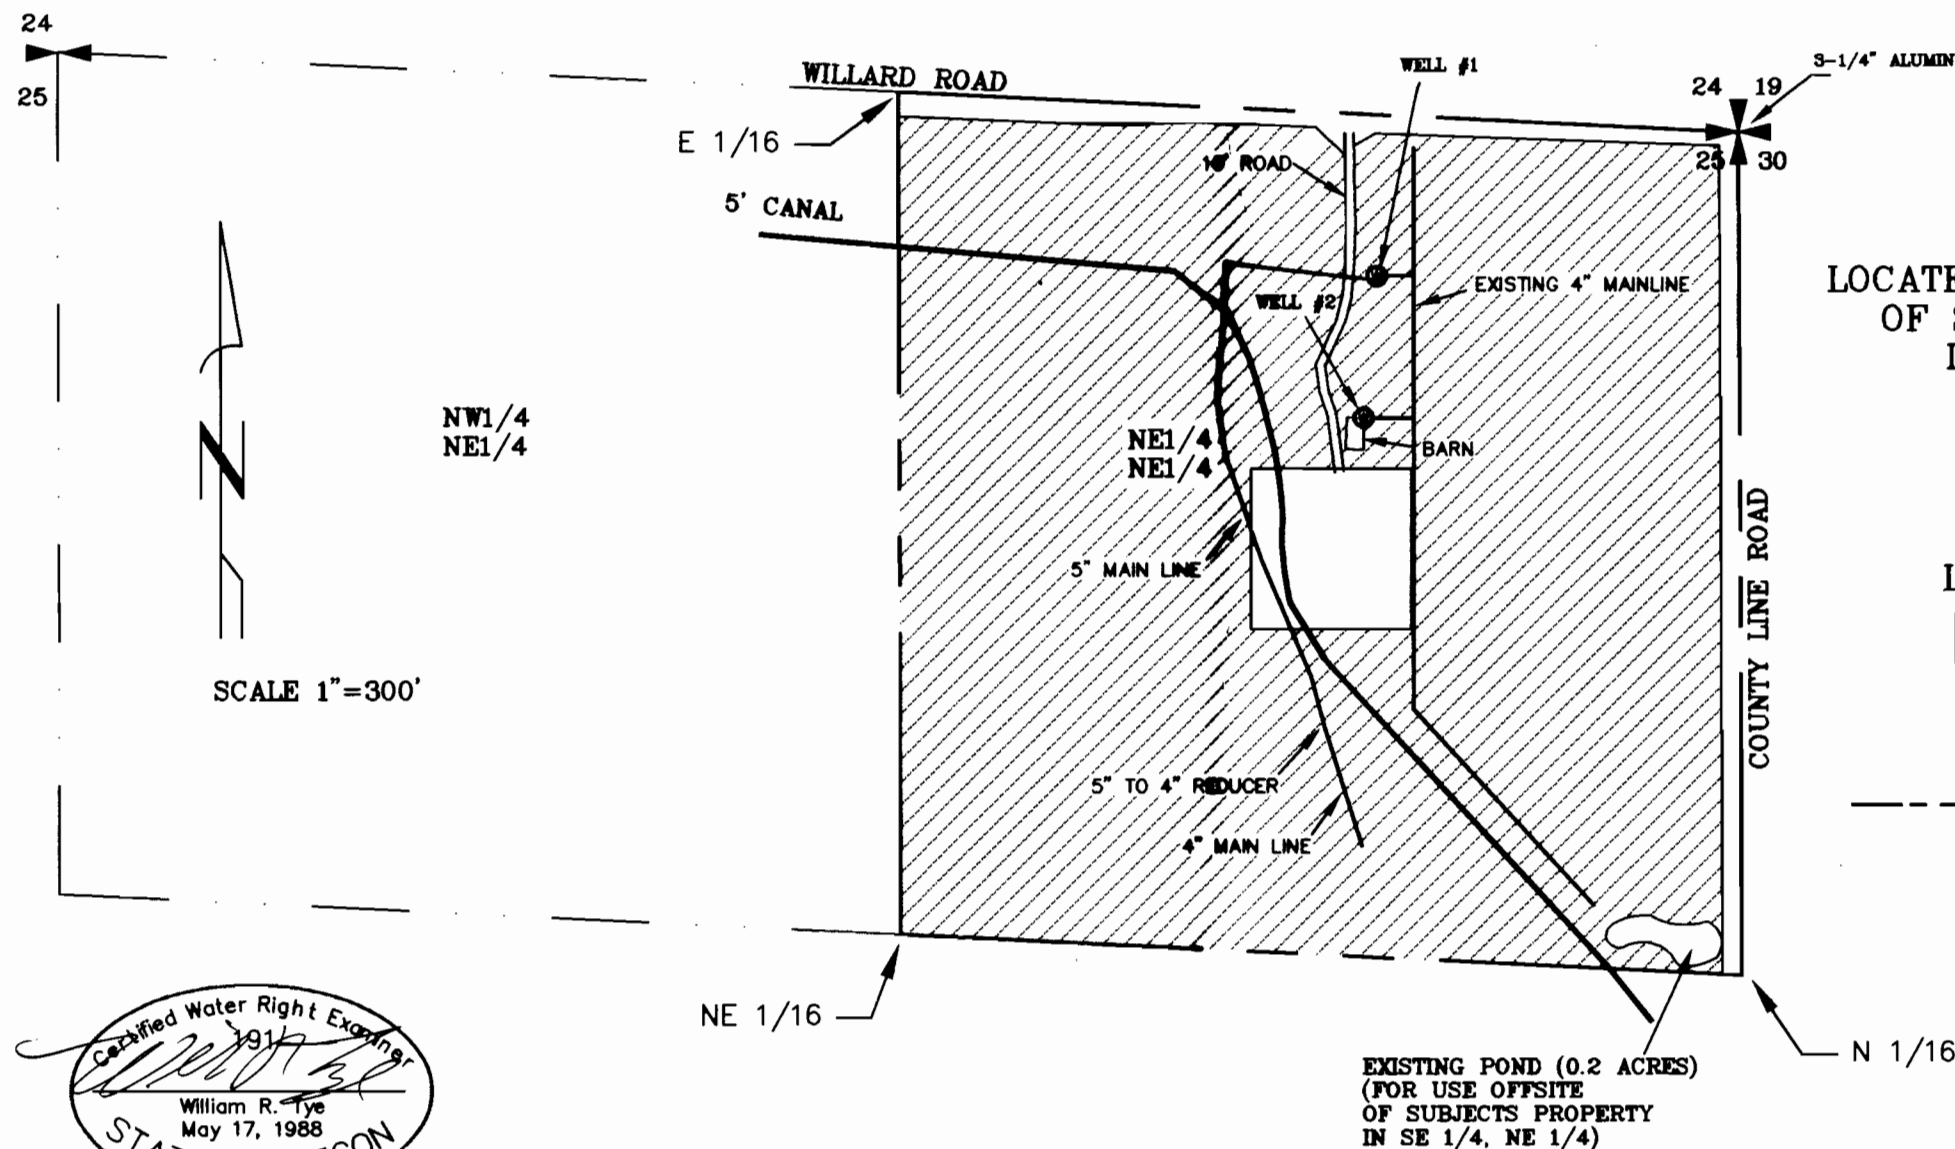

I, William R. Tye, Certified Water Right Examiner  
in the State of Oregon, hereby certify the subjoined  
application map was prepared under my direct  
supervision.

The preparation of this map is for the purpose  
of identifying the location of the water right only  
and has no intent to provide dimensions or locations  
of property ownership lines.

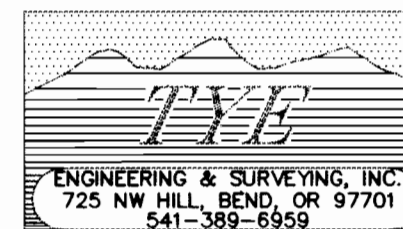

|                           |               |
|---------------------------|---------------|
| TITLE: FINAL PROOF SURVEY |               |
| JOB NO: 539-22            |               |
| SCALE: 1"=300'            | DRAWN BY: DPD |
| FIELD BOOK NO:            | DATE: 9/2/99  |
| DWG NAME: 552-22C         | SHEET: 1 OF 1 |