

FINAL PROOF SURVEY

FOR S-73018

Located in the NW 1/4 NW 1/4 of Section 23,

T. 26 S, R. 14 W., W.M.

Coos County, Oregon

15 14

22 23

N 1/4

W 1/16

PREPARED FOR:
PREPARED BY:
DATE SURVEYED:

DON & LAURA DORBUCK
DENNIS GOUDE
FEBRUARY 2, 1995

NOTE:
THE P.O.D. IS LOCATED
70 FEET NORTH AND
284 FEET WEST OF
THE NW 1/16 CORNER
OF SECTION 23, T. 26 S,
R. 14 W., W.M.

NW 1/4 NW 1/4

1" DIA PVC 201'

(.5 ac)

RESIDENCE

P.O.B.


N 1/16

P.O.D.

CN 1/16

P.O.D. IS AN IN-SPRING
COLLECTION BOX
4' X 4' X 8'.

NW 1/16

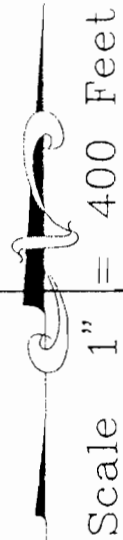

LEGEND

- P.O.D.
- P.O.B.
- RESIDENCE
- IRRIGATED AREA
- PIPE
- UNNAMED STREAM

NOTE:
LAWN, SHRUBS & GARDEN
TO BE IRRIGATED BY
GARDEN HOSE AND SPRINKLERS.

W 1/4

CW 1/16


C 1/4

EXAMINERS DISCLAIMER STATEMENT

NOTE:

The P.O.D. and Waterline is
entirely located on property
owned by the applicant.

The preparation of this map was for the purpose of
identifying the location of the Water Right only and
has no intent to provide dimensions or location of
property ownership lines.

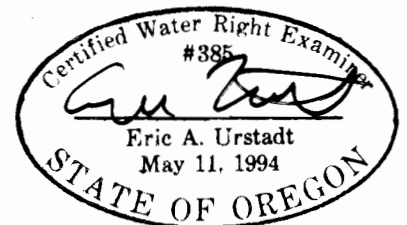

*Stuntzner Engineering
& Forestry*

705 So. 4th Street
P.O. Box 118
Coos Bay, Oregon 97420
Phone (503) 267-2872
Fax (503) 267-0588

Application No. 73018

Permit No. 51581