

RECEIVED

OCT 01 1999

WATER RESOURCES DEPT.
SALEM, OREGON

CLAIM OF BENEFICIAL USE
FINAL PROOF MAP

Located in the SE1/4 NW1/4 of Section 20
Township 23 South, Range 12 West, W.M.

Coos County, Oregon

Application S-83544

Permit 53470

Scale 1" = 100 Feet
Assessors Scale

Prepared For: Richard F. Bryan
Prepared By: Dennis Goude
Date Prepared: July 29, 1999


SE 1/4 NW 1/4
SECTION 20

NOTE:

The P.O.D. is an intake 3/4 HP submersible pump and is located 64 feet North and 1337 feet West from the Center 1/4 corner of Section 20.



EXPIRES 06/30/00

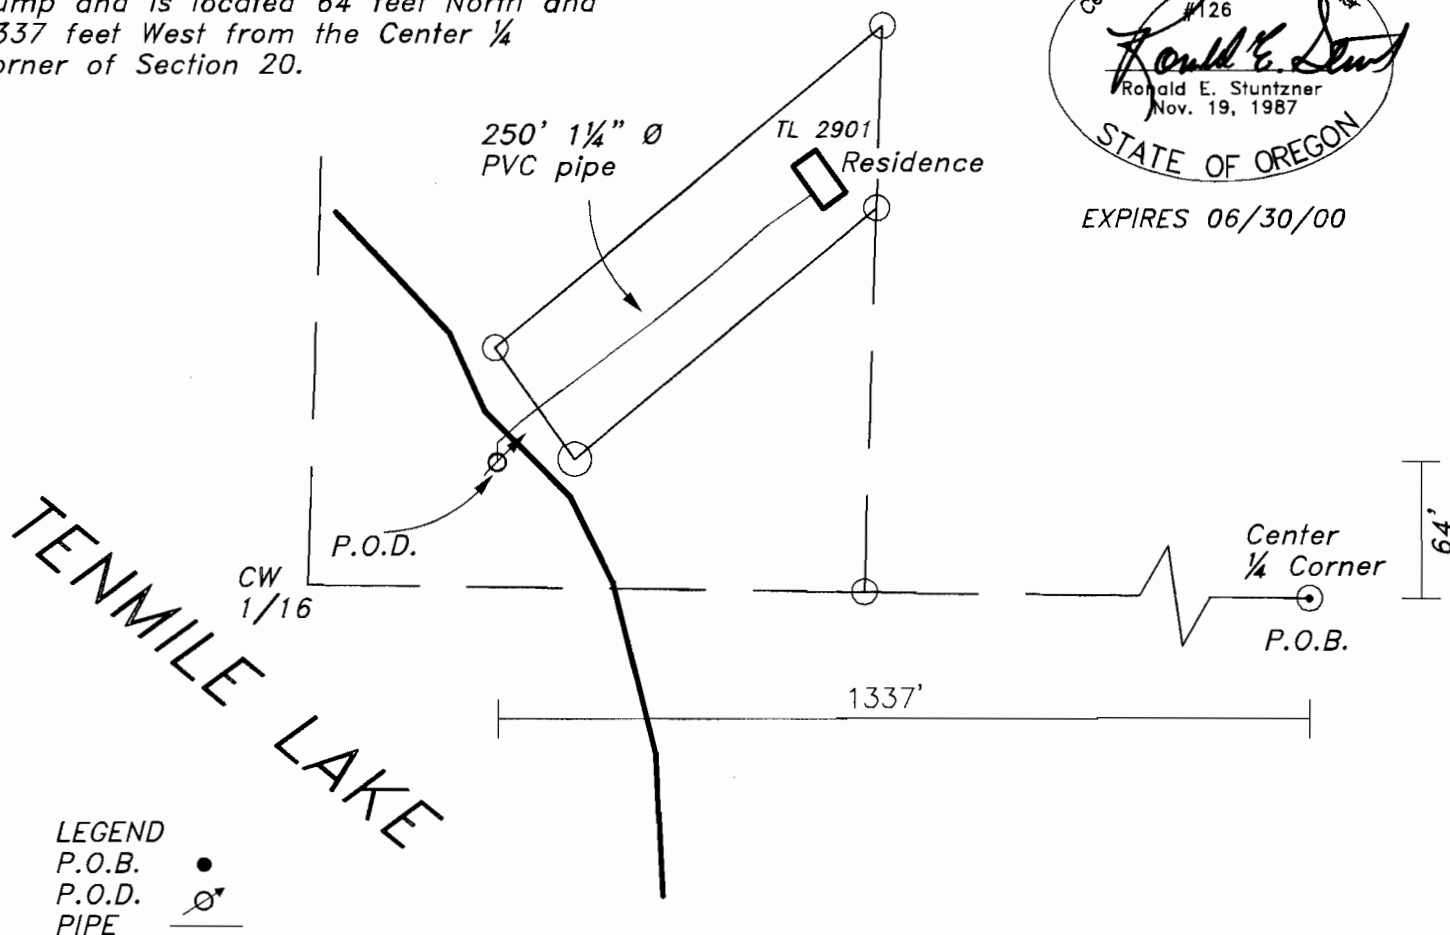

LEGEND
P.O.B. ●
P.O.D. ⊗
PIPE —⊗—

EXAMINERS DISCLAIMER STATEMENT

The preparation of this map was for the purpose of identifying the location of the Water Right only and has no intent to provide dimensions or location of property ownership lines.

Stuntzner Engineering
& Forestry, L.L.C.

ENGINEERING • LAND SURVEYING • FORESTRY
PLANNING • WATER RIGHTS

705 South 4th St.
Post Office Box 118
Coos Bay, Oregon 97420

Phone: (541) 267-2872
Fax: (541) 267-0588