


# T. 36 S., R. 6 W., W.M.

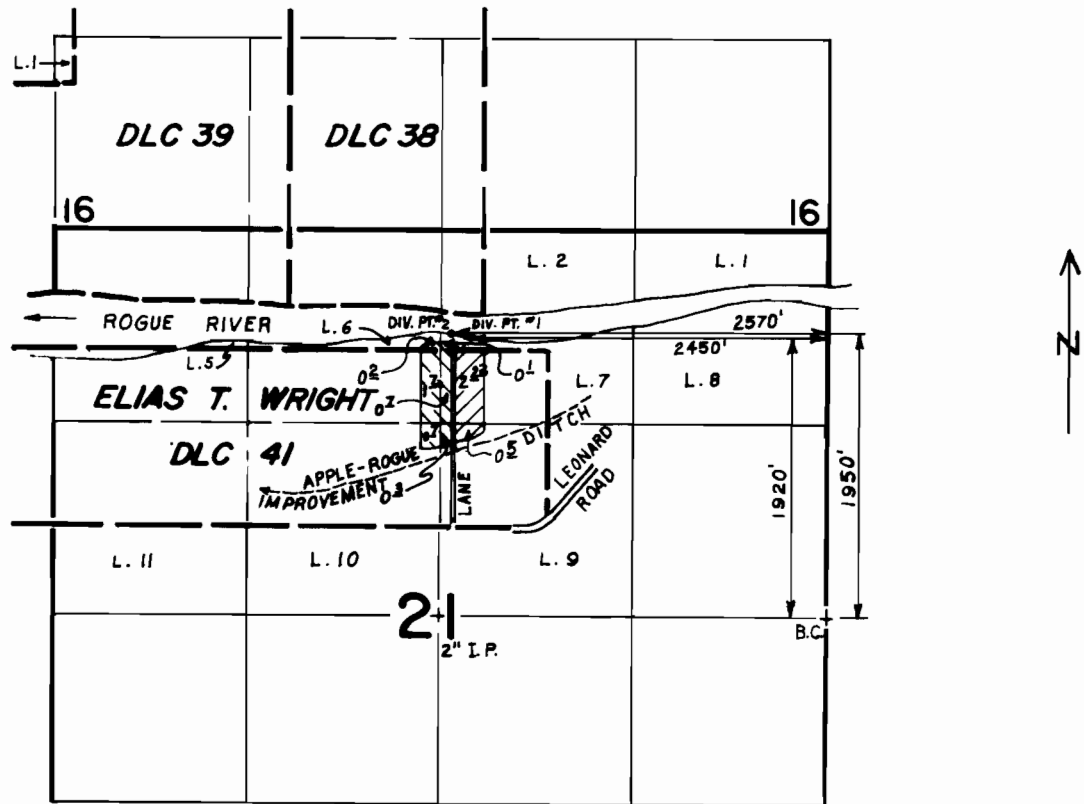

SCALE: 4" = 1 MILE

IRRIGATED from DIV. PT. #1. (BUSHONG)

IRRIGATED from DIV. PT. #2. (HANSGEN)

## FINAL PROOF SURVEY UNDER

Application No. 52009 Permit No. 39204  
IN NAME OF

*Arthur B. Hansgen & Charles R. Bushong*

Surveyed JAN. 18, 1984, by B. S. JAMES