


Trut
R.
Sec
1" = 40'

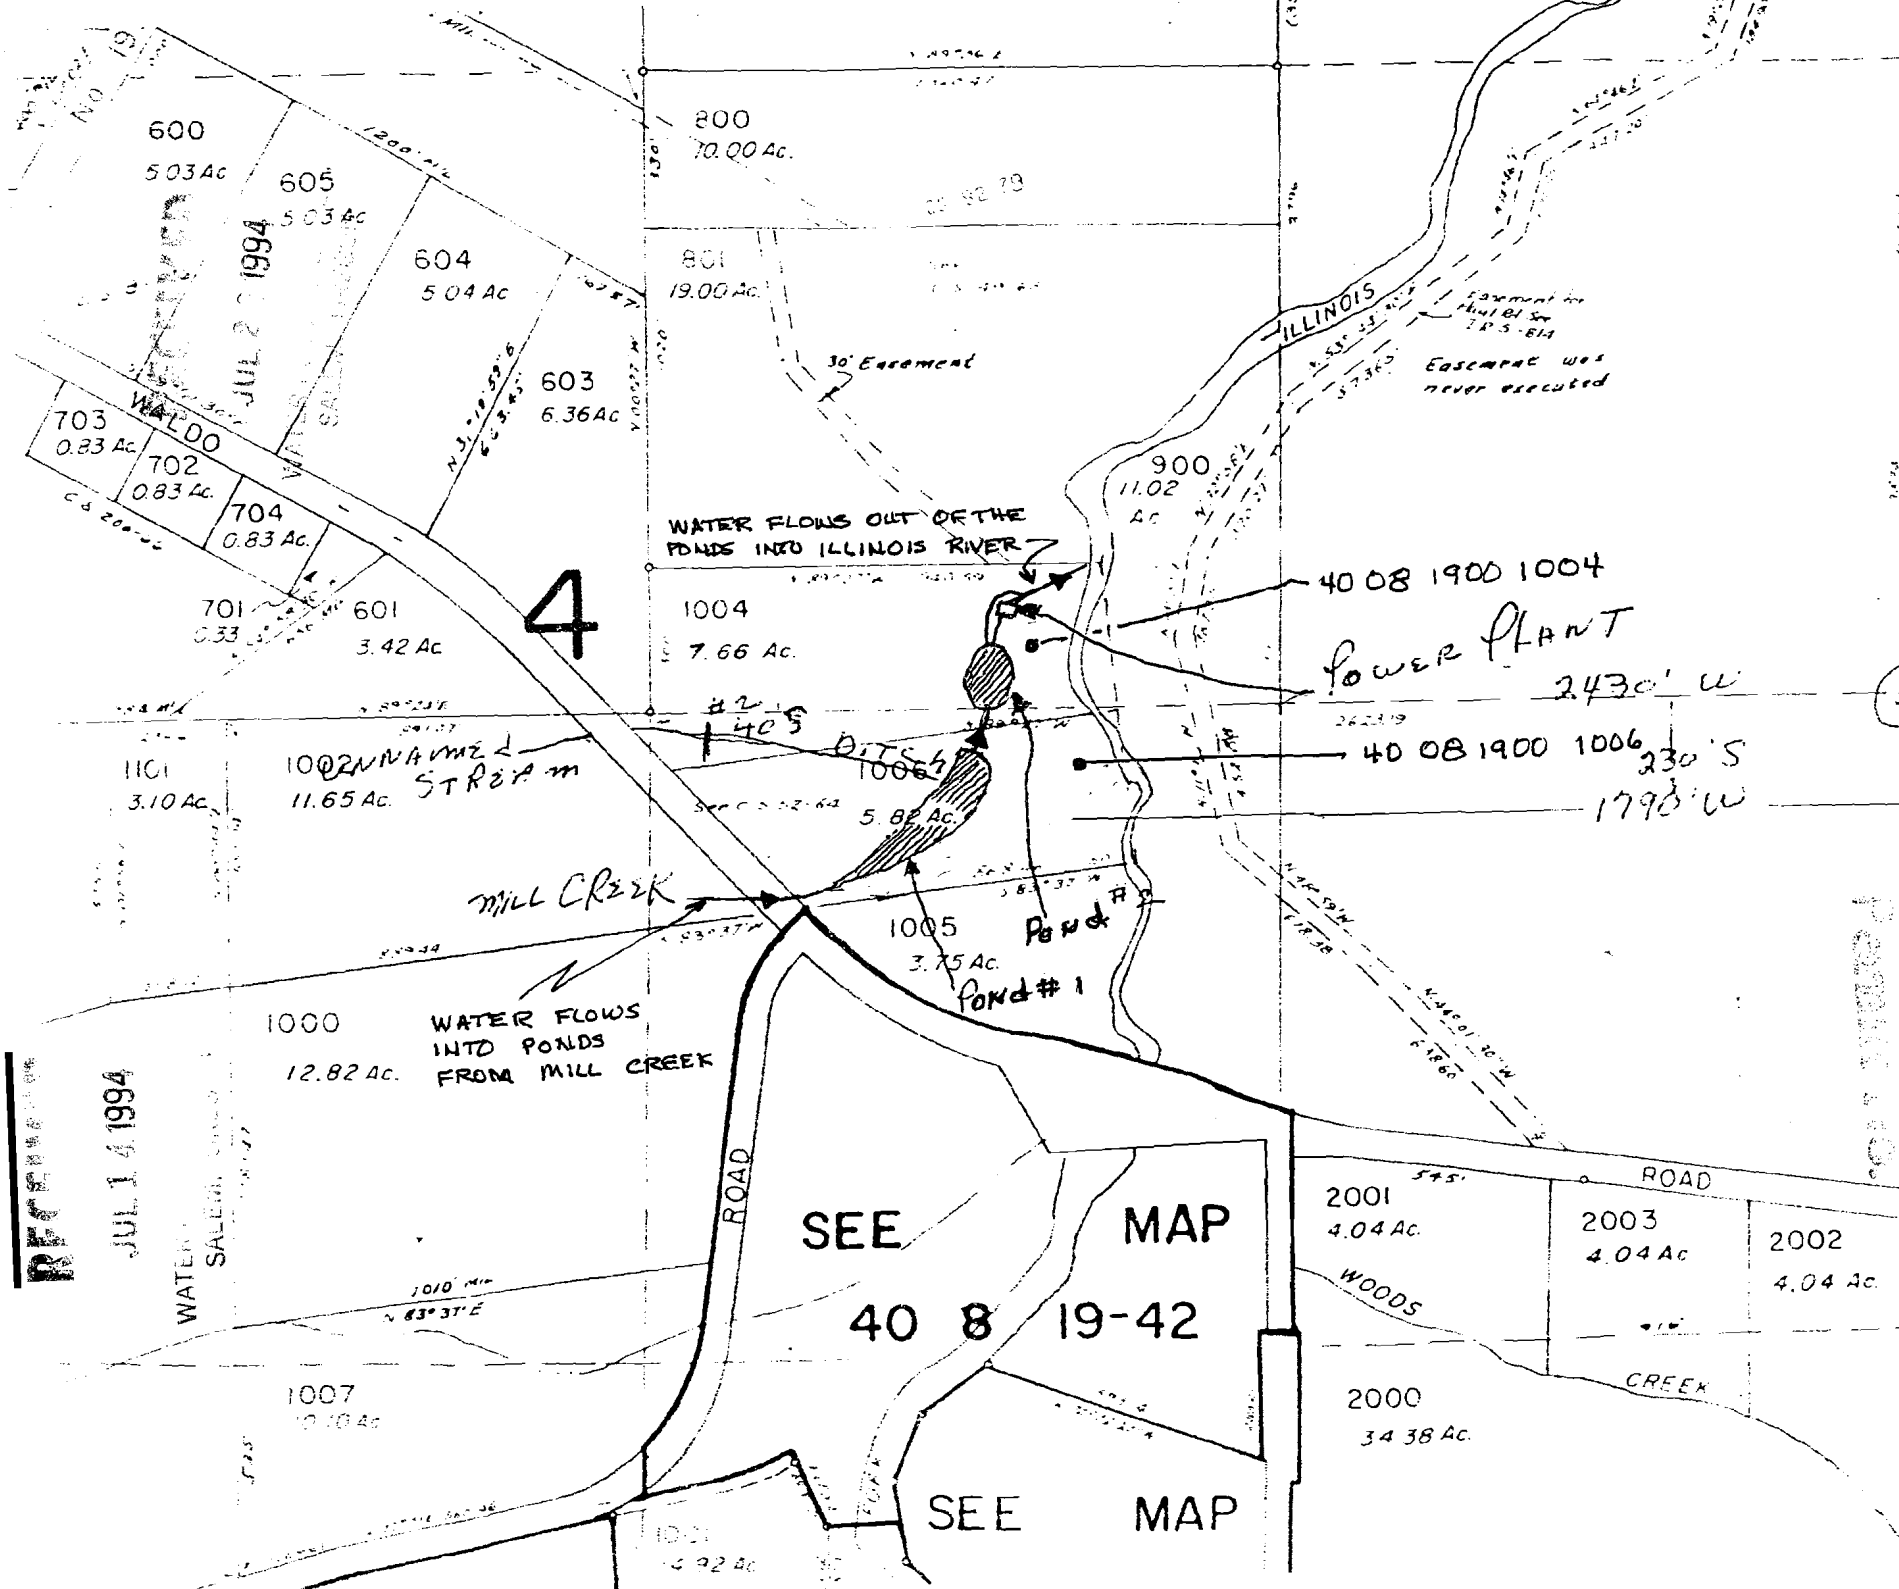

SEE MAP 40 8 20

SEE MAP 40 8 20

SEE MAP 40 8 20

76511

69192

R74325

REC-100

JUL 14 1994

JUL 2 1994

SEE MAP 40 8 19-42

SEE MAP

WATER FLOWS INTO PONDS FROM MILL CREEK

WATER FLOWS OUT OF THE PONDS INTO ILLINOIS RIVER

Easement for
Chul of SA
TR 5-814
Easement was
never executed

Pond #1
Pond #2

40 08 1900 1004
POWER PLANT
2430' W

40 08 1900 1006
230' S
1790' W

1002 NAME 2
STREAM
11.65 Ac.

1000
12.82 Ac.

1004
7.66 Ac.

900
11.02 Ac.

801
19.00 Ac.

603
6.36 Ac.

604
5.04 Ac.

605
5.03 Ac.

600
5.03 Ac.

703
0.83 Ac.

702
0.83 Ac.

704
0.83 Ac.

701
0.33 Ac.

601
3.42 Ac.

1101
3.10 Ac.

1005
3.75 Ac.

1006
5.82 Ac.

2001
4.04 Ac.

2003
4.04 Ac.

2002
4.04 Ac.

2000
34.38 Ac.

1007
10.10 Ac.

1001
1.92 Ac.

No Final Proof Map available

No Permit Map available