


# T. 1 N. & 1 S. R. 39 E. W. M.

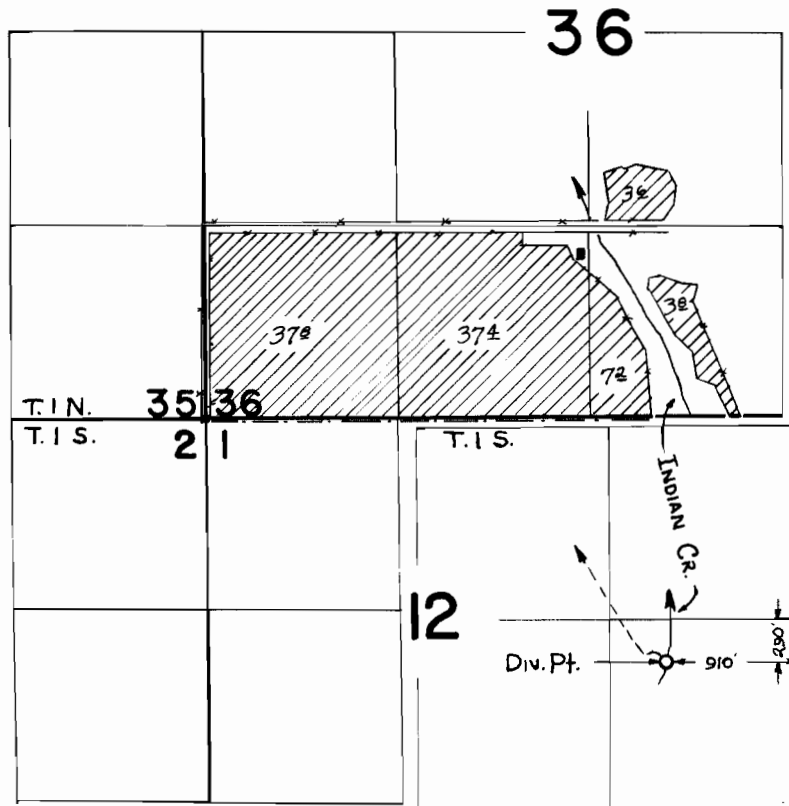

## FINAL PROOF SURVEY UNDER

Application No. 41599 ..... Permit No. 31027.....  
IN NAME OF

SPENCER TOLLEY

Surveyed 22 JULY 1969, by W. J. RUPPERT