

T. 26 S., R. 15 E., W.M.


FINAL PROOF SURVEY

UNDER
APPLICATION NO. G-9126 PERMIT NO. G-8551
IN NAME OF



THEODORE R. TIAHRT OF DOUBLE TREE RANCH


SURVEYED AUG 24, 1993, BY R.M. SUTTERFIELD
SCALE: 1" = 660'

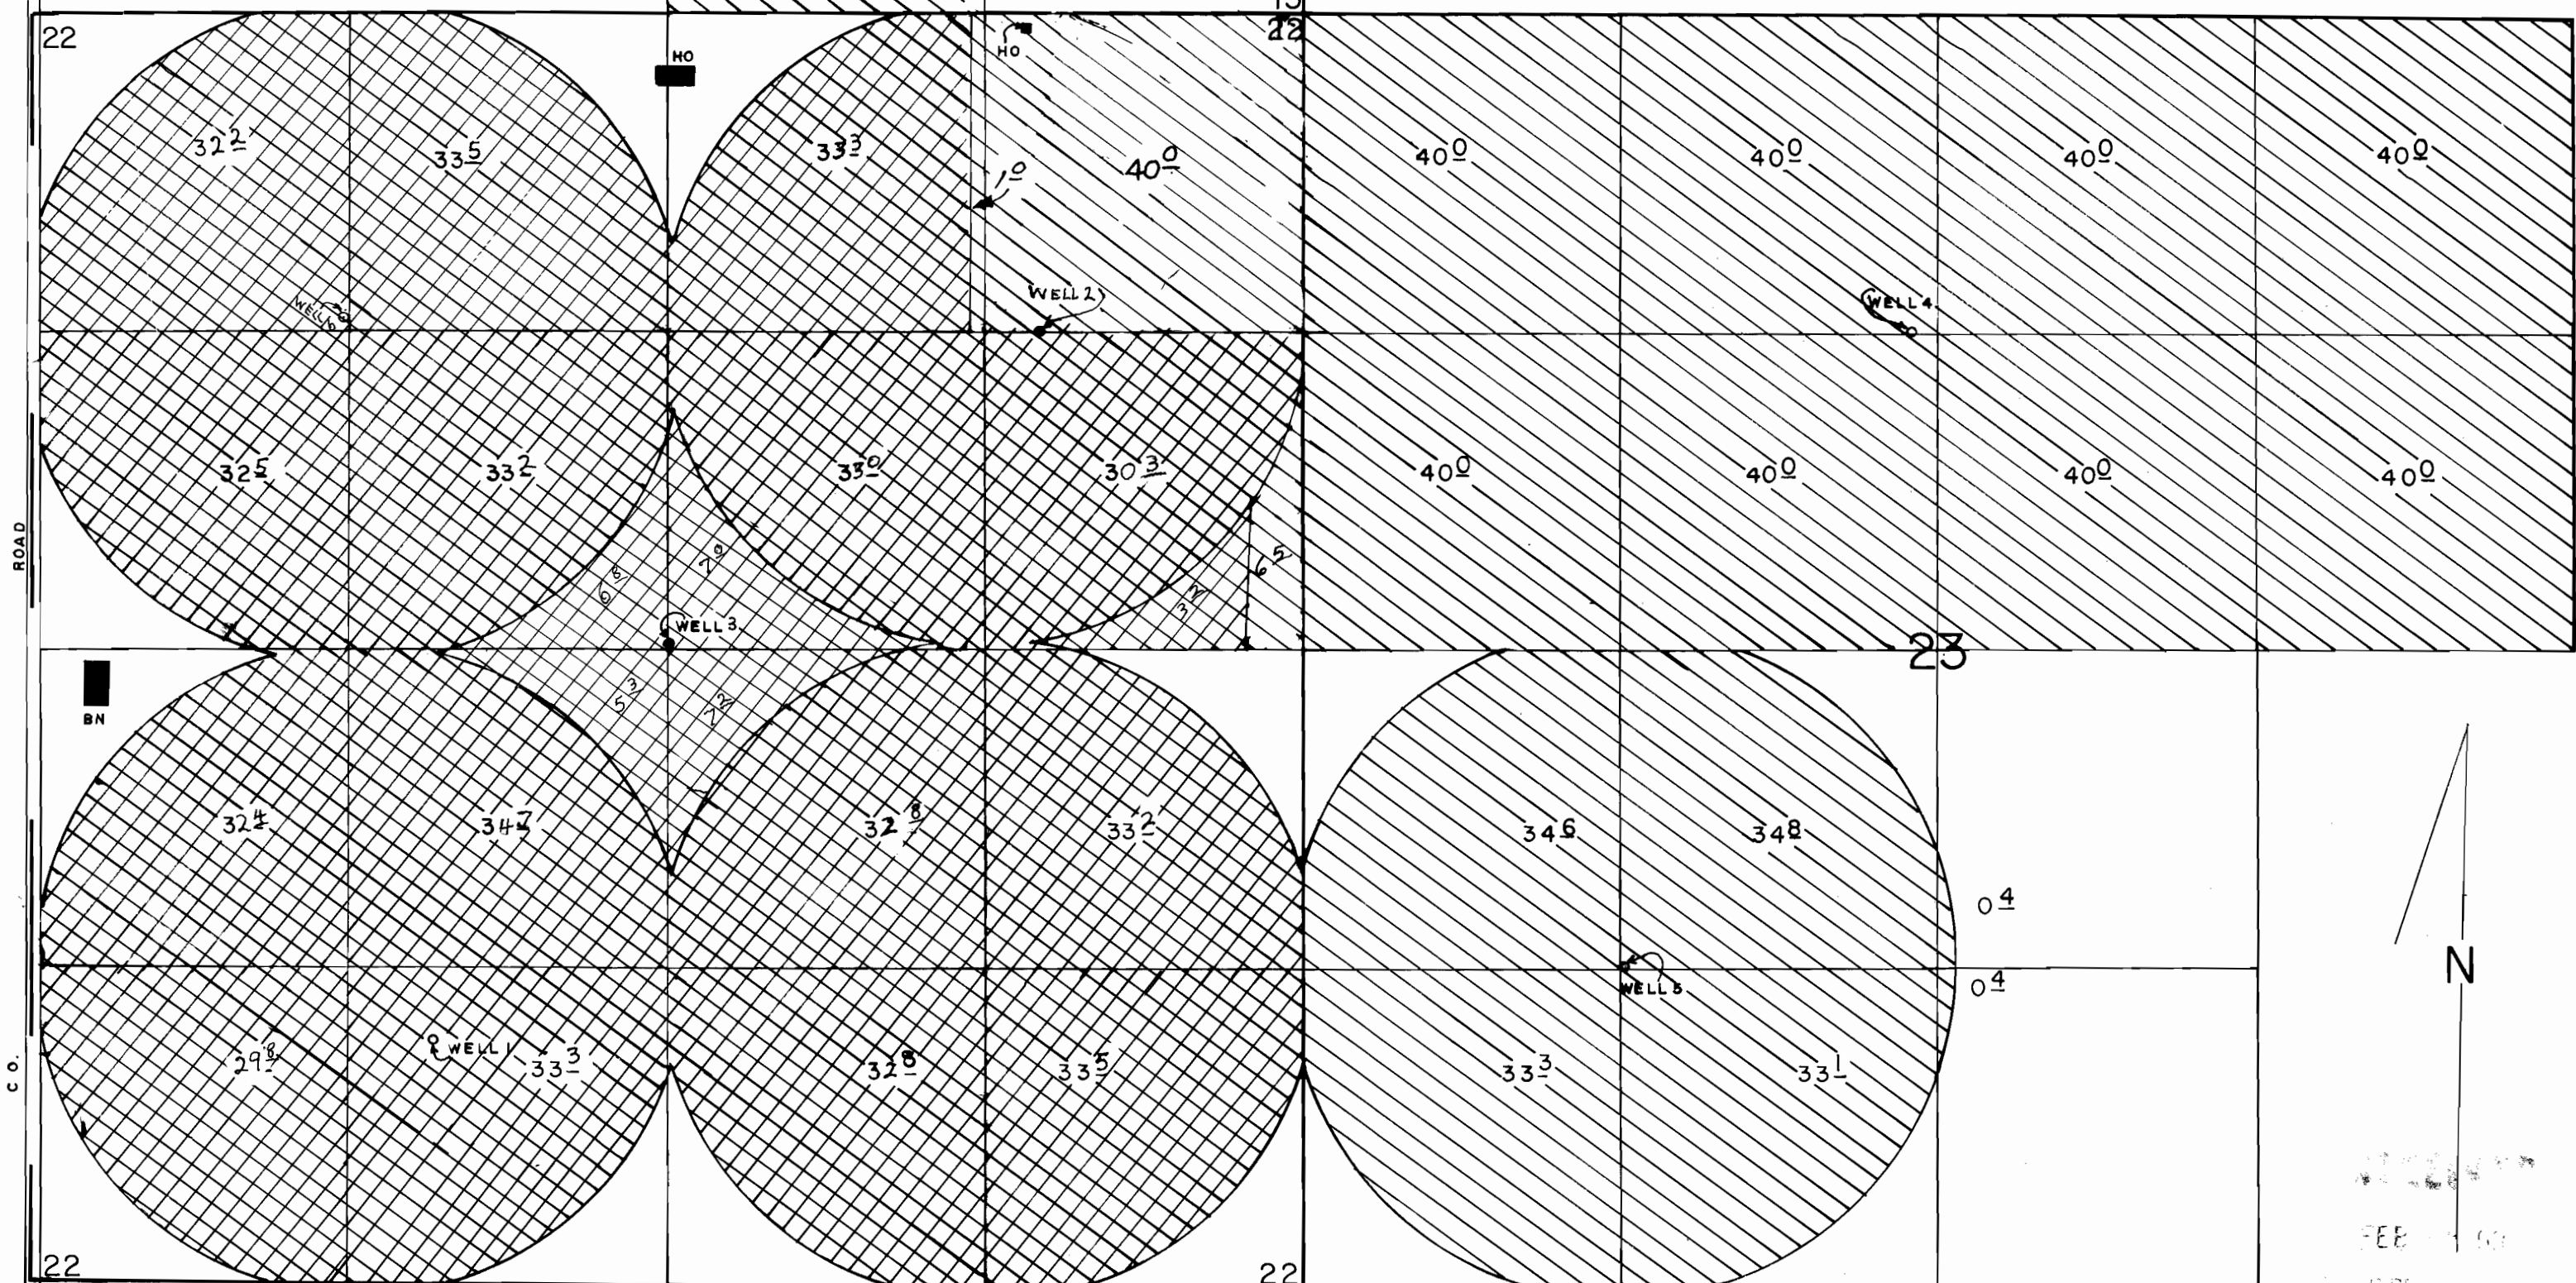

12/29/93 by R.M.S.
PHOTO ASC COPY 41037-1689-130 L

WELL 1 LOC: 1120' N & 1650' E FROM SW COR. OF SEC 22.
WELL 2 LOC: 1300' S & 1130' W FROM NE COR. OF SEC 22.
WELL 3 LOC: 2560' N & 2725' E FROM SW COR. OF SEC 22.

WELL 4 LOC: 1310' S & 2530' E FROM NW COR. OF SEC 23.
WELL 5 LOC: 1330' N & 1330' E FROM SW COR. OF SEC 23.
WELL 6 LOC: 2620' S & 2630' W FROM NE COR. OF SEC 22.

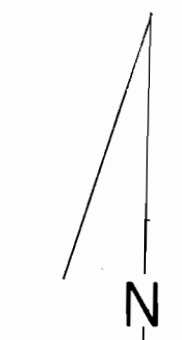

FEB 1994
AS RES...
A.P.M.