




# T. 27 S., R. 11 W., W.M.

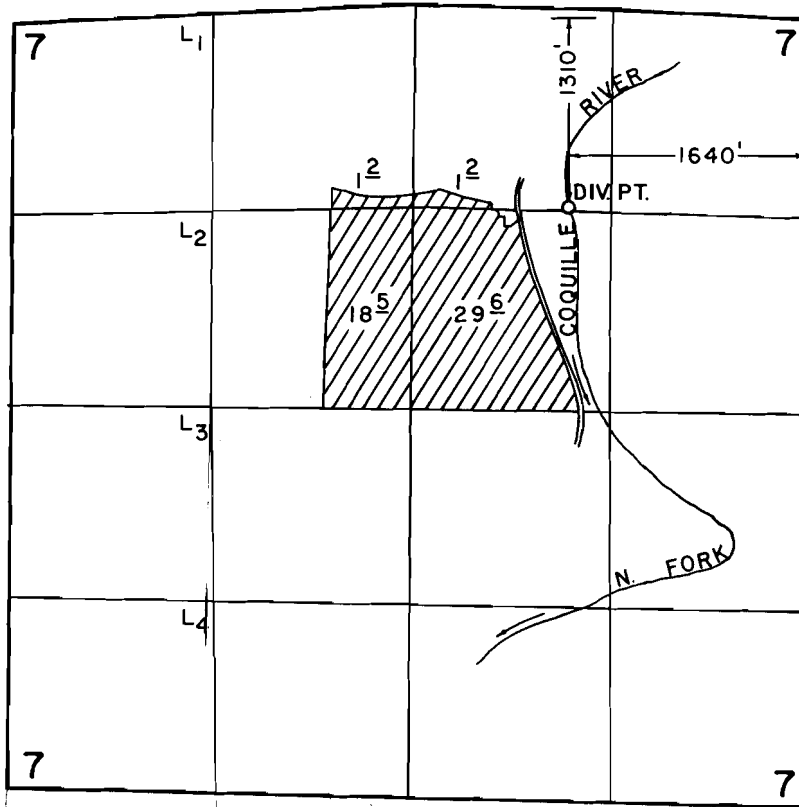

SCALE: 1" = 1320'

## FINAL PROOF SURVEY UNDER

Application No. 62139 Permit No. 46358...  
IN NAME OF

JOE F. BARRY

Surveyed SEPT. 17 1988, by Z. SALEH