


SECTION 33 & 34, T.3S.,
YAMHILL COUNTY, OR

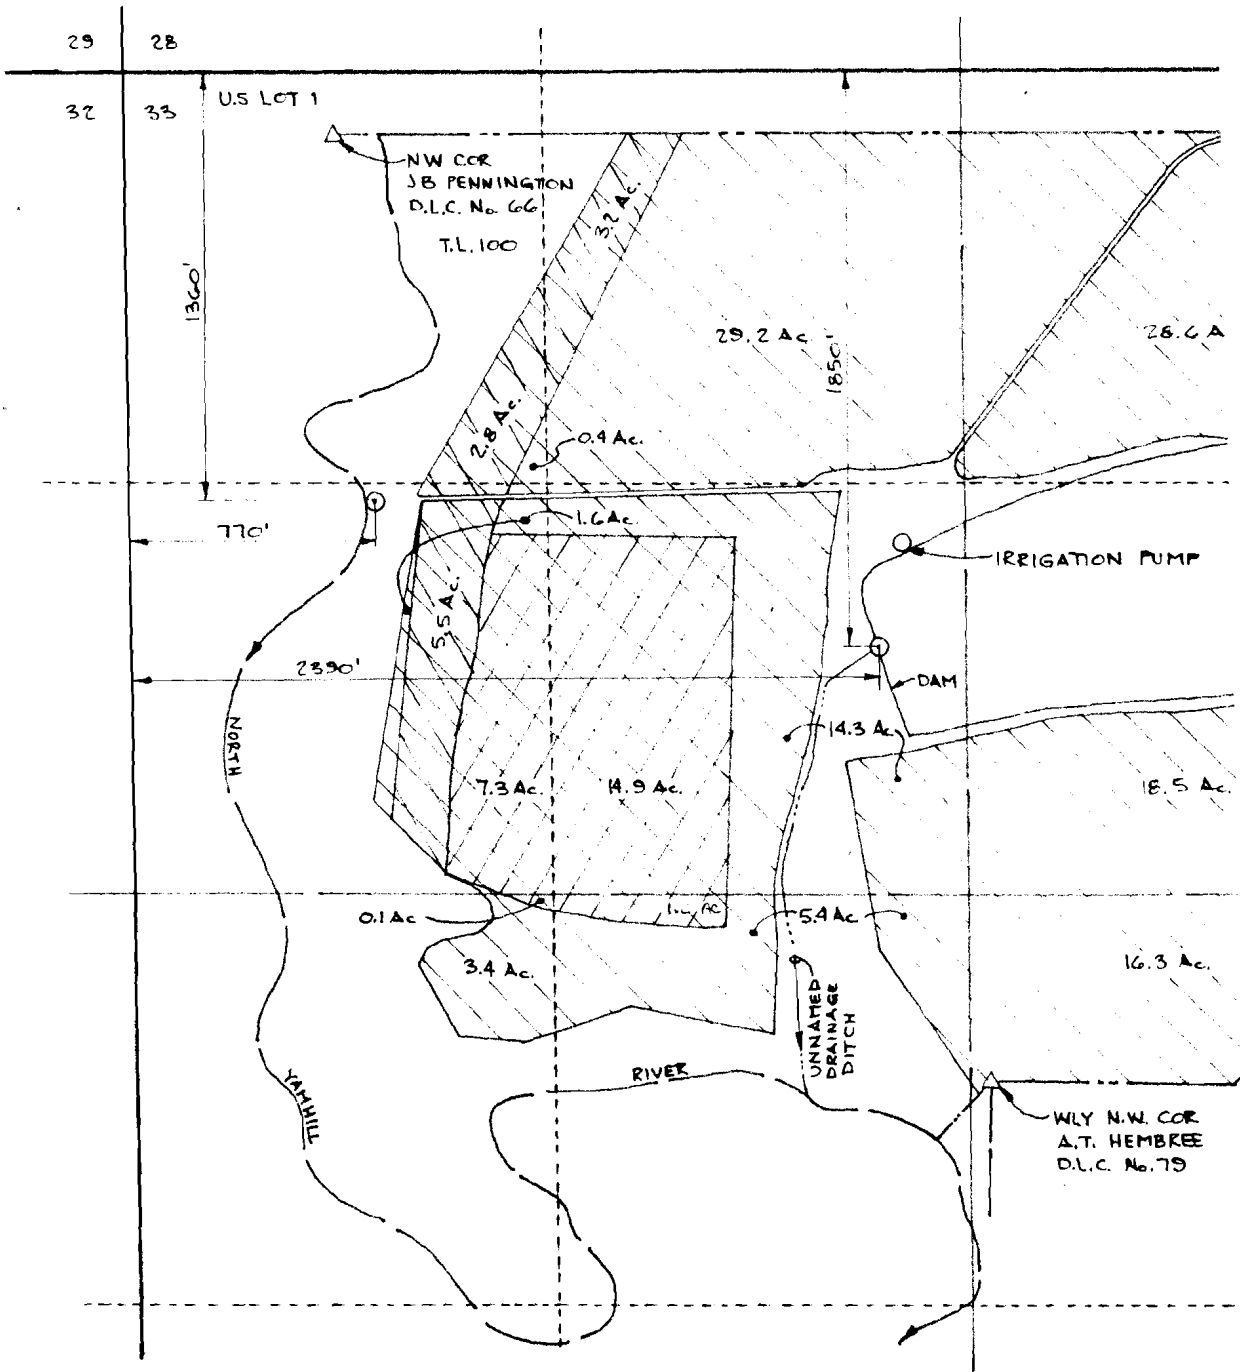


FINAL PROC
UNDER
APPLICATIONS
PERMITS
SURVEYED

VERBOORT ENGINEERING

AGRICULTURE · CIVIL · WATER RESOURCES

	by	date
designed	WKV	9-8-98
drawn	JER	9-8-98

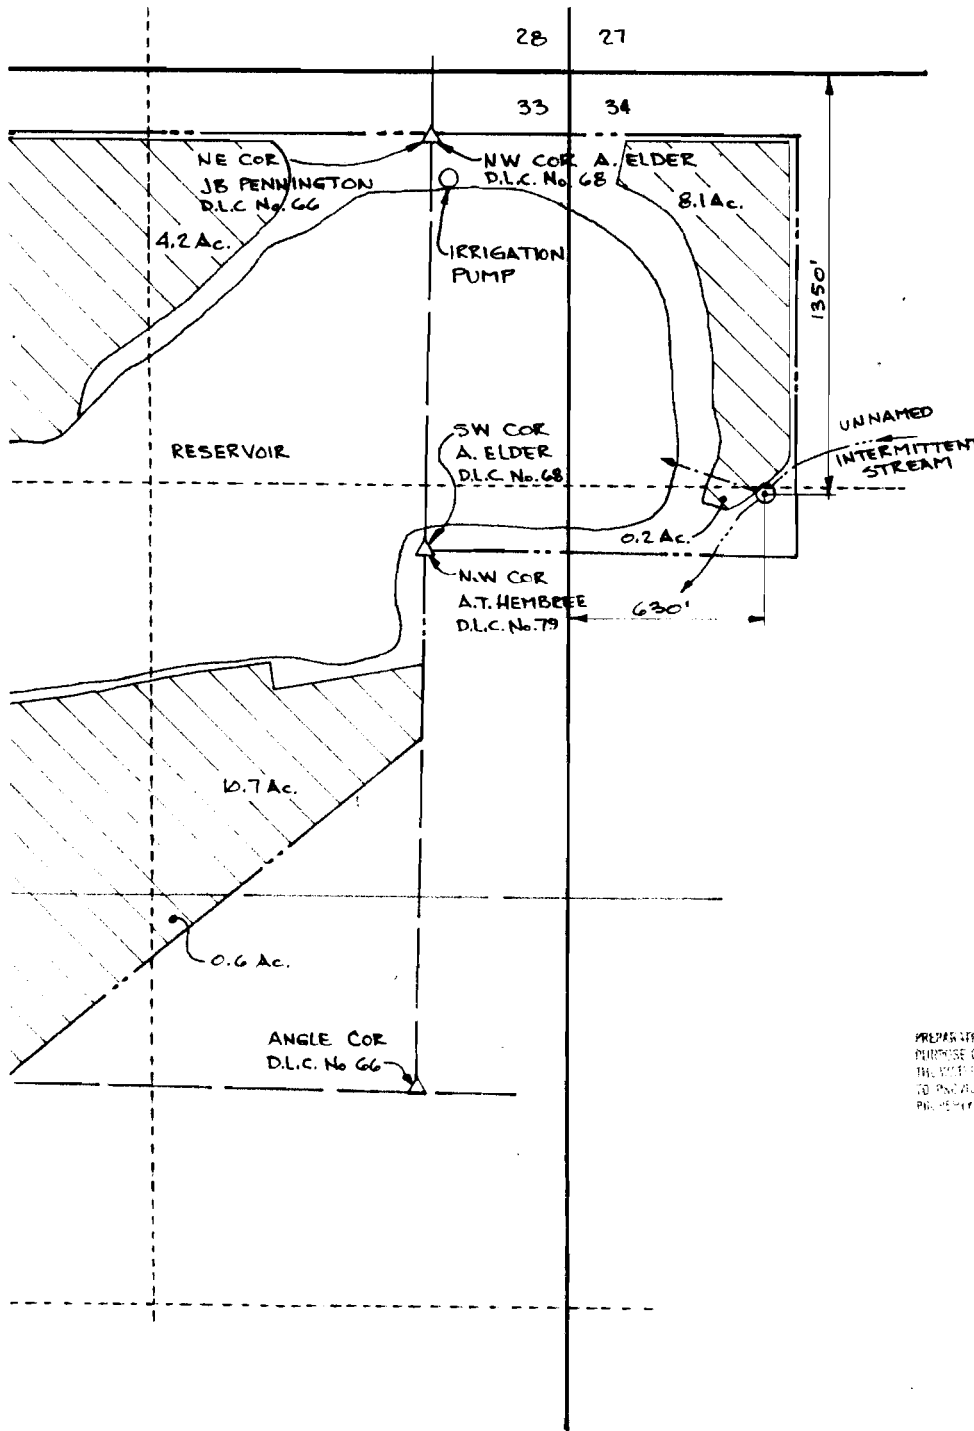

OF SURVEY

R

R-73260, 73261

R-11492, 51527

8-27-98



BAILEY NURSERIES, INC.

9855 N.W. PIKE RD.
YAMHILL, OR 97148