

NW1/4, SE1/4

NE1/4, SE1/4

1160 FEET NORTH  
901 FEET WEST  
OF SE CORNER  
SECTION 2  
SPRING

HOUSE

POINT OF DIVERSION

COUNTY ROAD

SW1/4, SE1/4

SE1/4, SE1/4

FND BCIP

2 1  
11 12


THE PREPARATION OF THIS MAP WAS FOR THE PURPOSE OF IDENTIFYING  
THE LOCATION OF THE PROPOSED WATER RIGHT AND HAS NO INTENT TO  
PROVIDE DIMENSIONS OR LOCATION OF PROPERTY LINES.

T. 36 S., R. 14 W., W. M.

# FINAL PROOF SURVEY

APPLICATION #68998 UNDER PERMIT #49952

IN THE NAME OF  
JOSEPH L. EMERICK

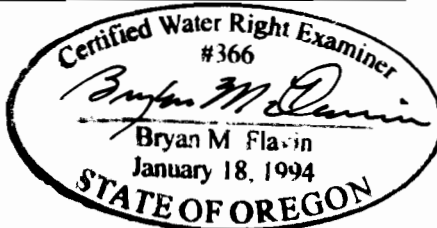

RECEIVED

RECEIVED

APR 20 2000

WATER RESOURCES DEPT.  
SALEM, OREGON



1" = 400'

BRYAN FLAVIN LAND SURVEYING  
BRYAN M. FLAVIN  
REGISTERED LAND SURVEYOR  
CERTIFIED WATER RIGHTS EXAMINER  
32053 SQUAW VALLEY ROAD  
GOLD BEACH, OREGON 97444  
541-247-6485  
CWRE #366

SURVEYED FEBRUARY 8, 1998 BY BRYAN M. FLAVIN