


T. 35 S., R. 2 W., W.M.

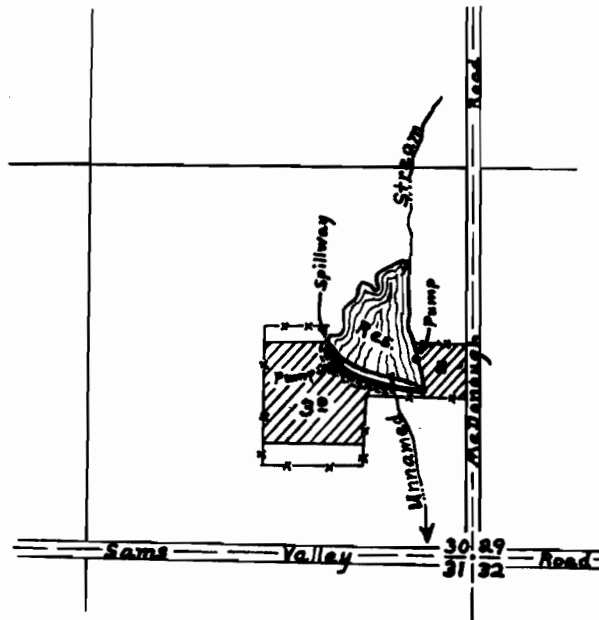

(Scale: 8" = 1 mile)

FINAL PROOF SURVEY UNDER

Application No. R-31868 Permit No. R-2072
31869 25121
IN NAME OF


Ralph A. James

Surveyed March 20, 1962, by D. L. Hendrix

T. 35S., R. 2 W., W.M.

Sec. 30

SE 1/4 SE 1/4

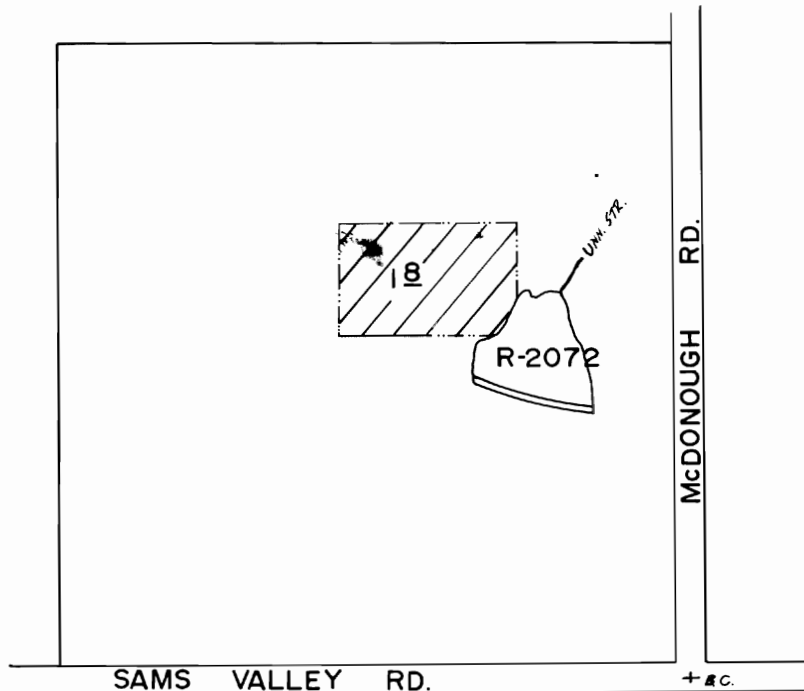

Scale 1" = 400'

FINAL PROOF SURVEY
UNDER

Transfer No. 4272

Application No. Permit No.
IN NAME OF

JANET W. VIGIL

Surveyed Oct. 17, 1984, by J.R. WOODROOF