


T. 10S. R. 2W. W.M.

RECEIVED

MAR 19 1999

WATER RESOURCES DEPT
SALEM, OREGON

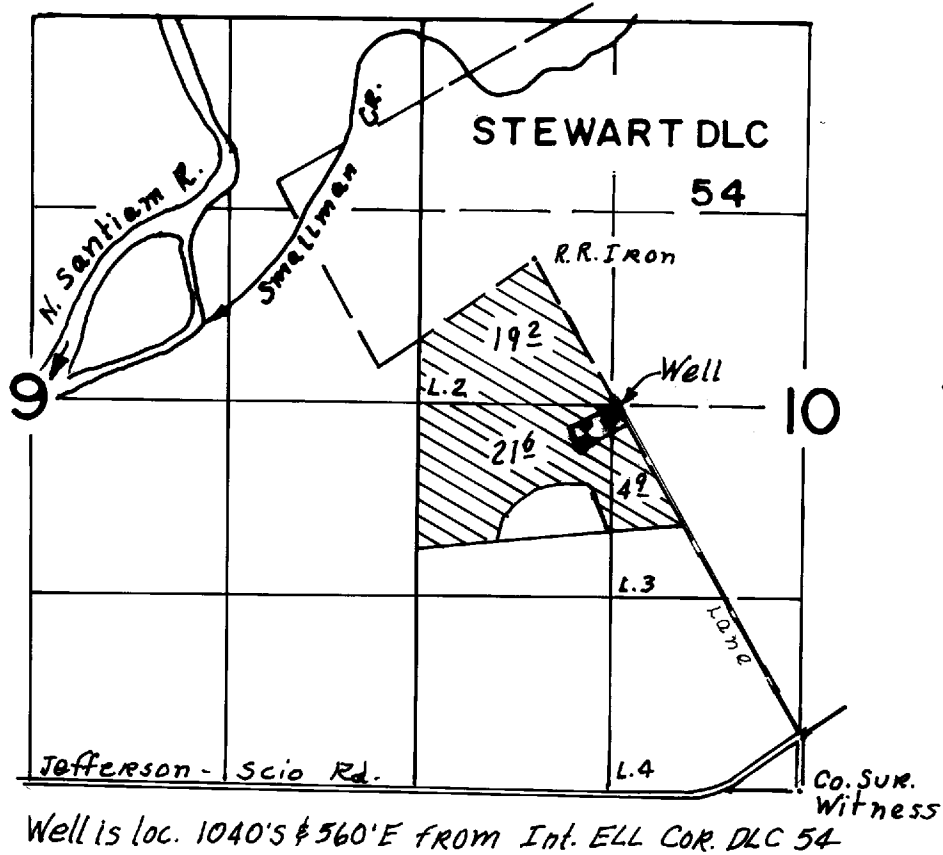


FINAL PROOF SURVEY
UNDER

Application No. G-13516 Permit No. G-12074
IN NAME OF

TRACY E. MOUNT

Surveyed Mar. 12 19 99, by

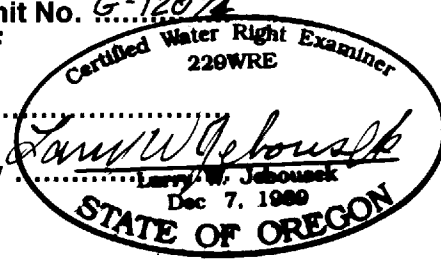

THIS MAP WAS PREPARED FOR THE PURPOSE OF IDENTIFYING THE LOCATION OF A WATER RIGHT ONLY AND IS NOT INTENDED TO PROVIDE LEGAL DIMENSIONS OR LOCATION OF PROPERTY OWNERSHIP LINES.

WAC-ODFW-93 6-25