


FINAL PROOF SURVEY
UNDER
APPLICATION NO. S-71819 PERMIT NO. 51802
IN THE NAME OF
CHRISTOPHER LAMB
SURVEYED AUGUST 21, 1999

This map is for the purpose
of identifying the location of the
water right only and is not intended
to provide legal dimensions or location
of property ownership lines.

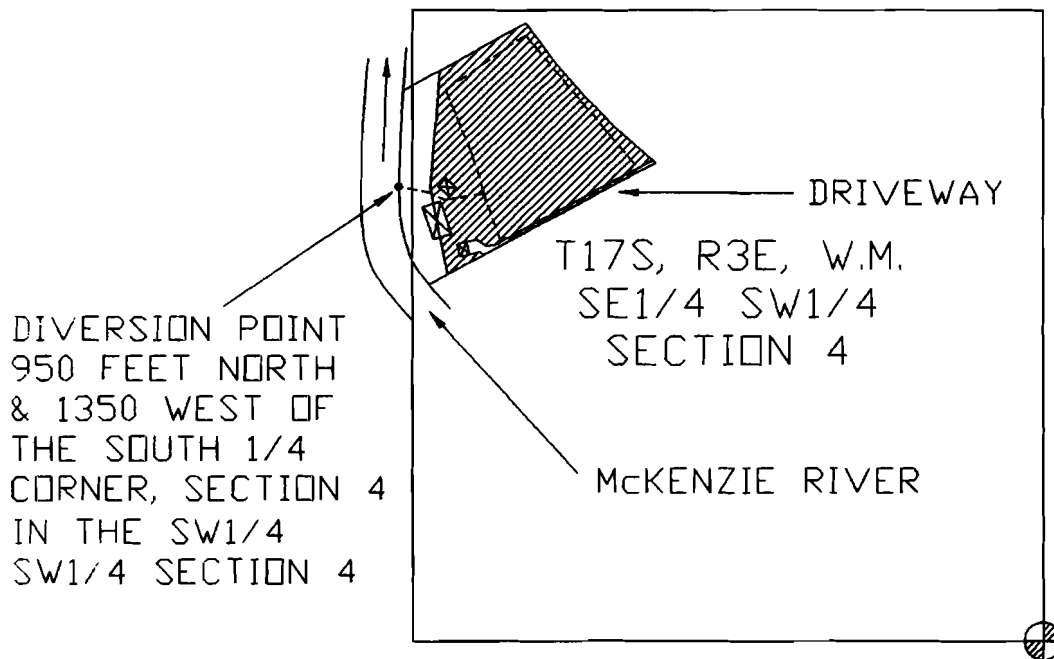

BUILDINGS



IRRIGATED AREA 3.0 ACRES



BURIED UNDERGROUND WATERLINE

RECEIVED

OCT 18 1999

WATER RESOURCES DEPT
SALEM, OREGON

