


T.20S., R. 26E., W.M.

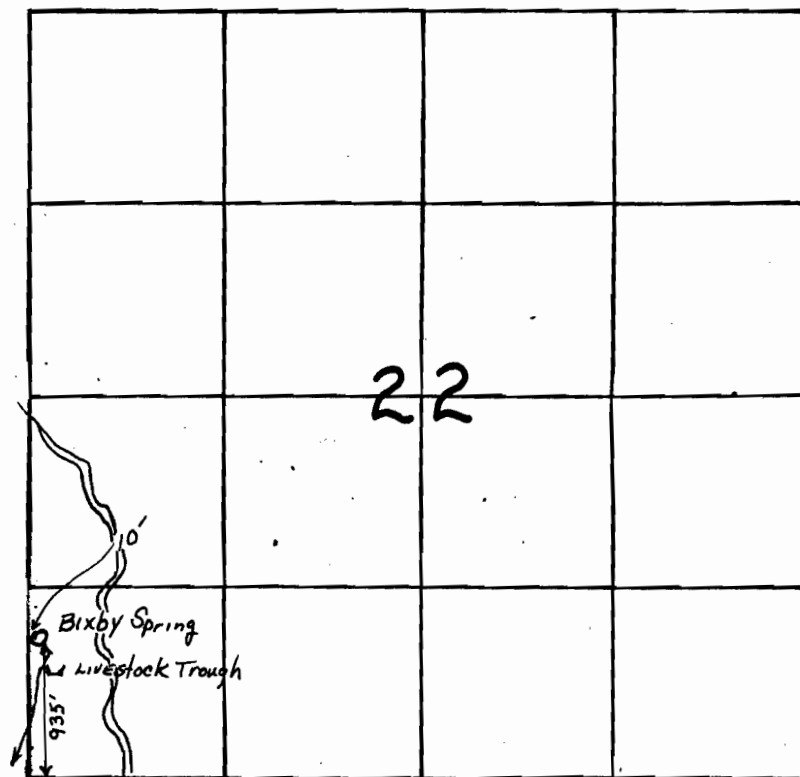

SCALE - 4" = 1 MILE

RECEIVED
MAY 8 1983
WATER RESOURCES DEPT.
SALEM, OREGON

Application No. 60880
Permit No. 48533