
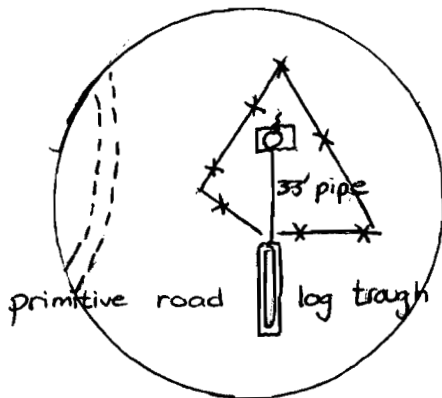


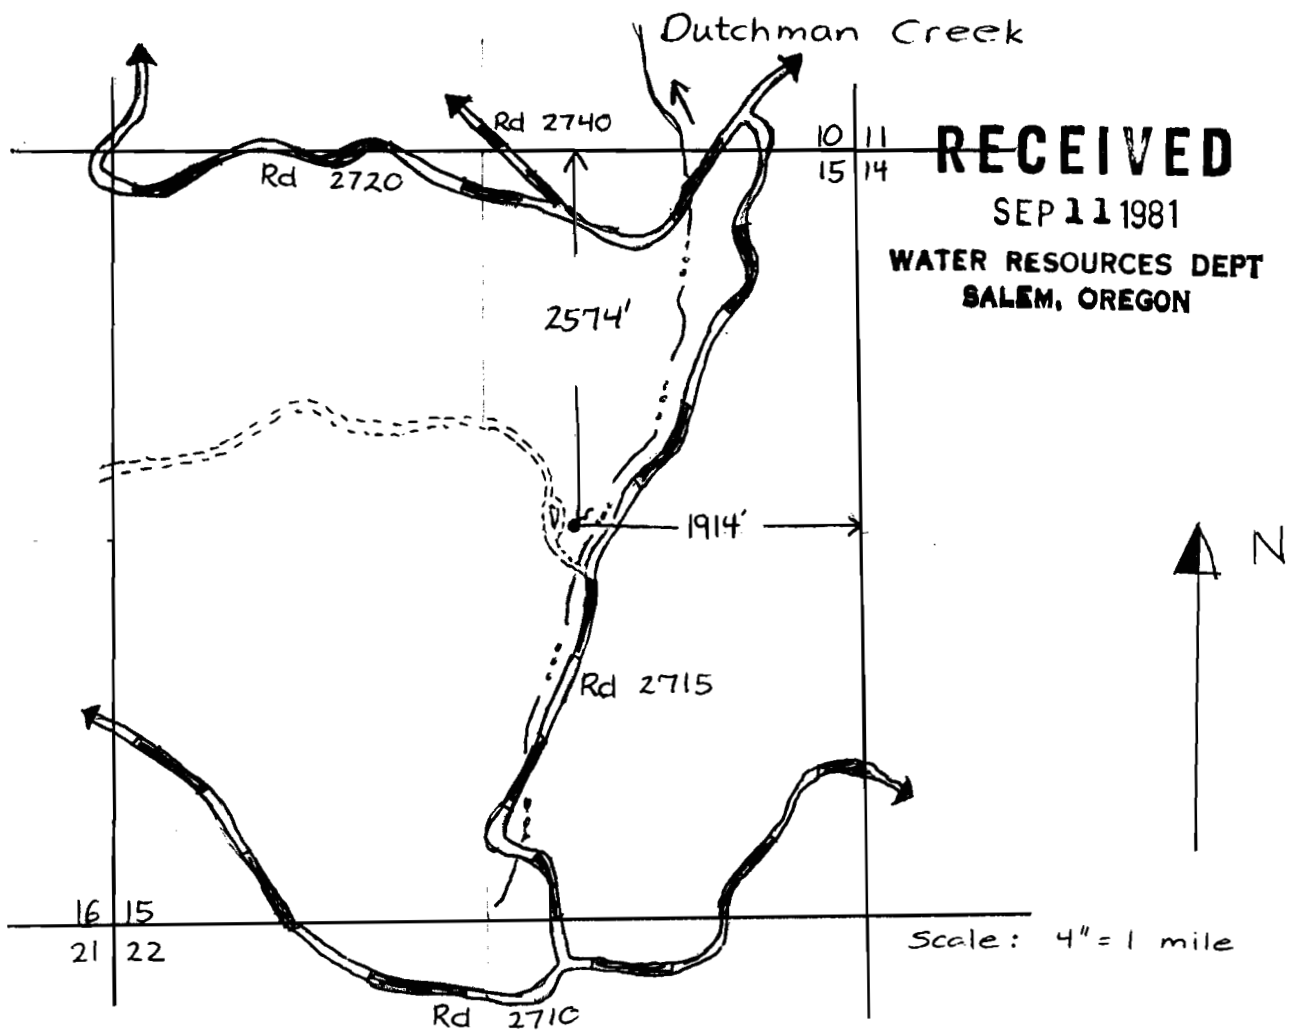

Dutchman Spring
 SW $\frac{1}{4}$, NE $\frac{1}{4}$, Sec. 15, T12S, R 17E

Application No. 62712
 Permit No. 48645

C 76544