OCHOCO NATIONAL FOREST PAULINA RANGER DISTRICT

scale 5.28 inches = 1 mile T 16S R 26E Sec 17 NW¼ of SE ¼

WILLOW SPRING TROUGHS

Application No. 62705

Permit No. 48643

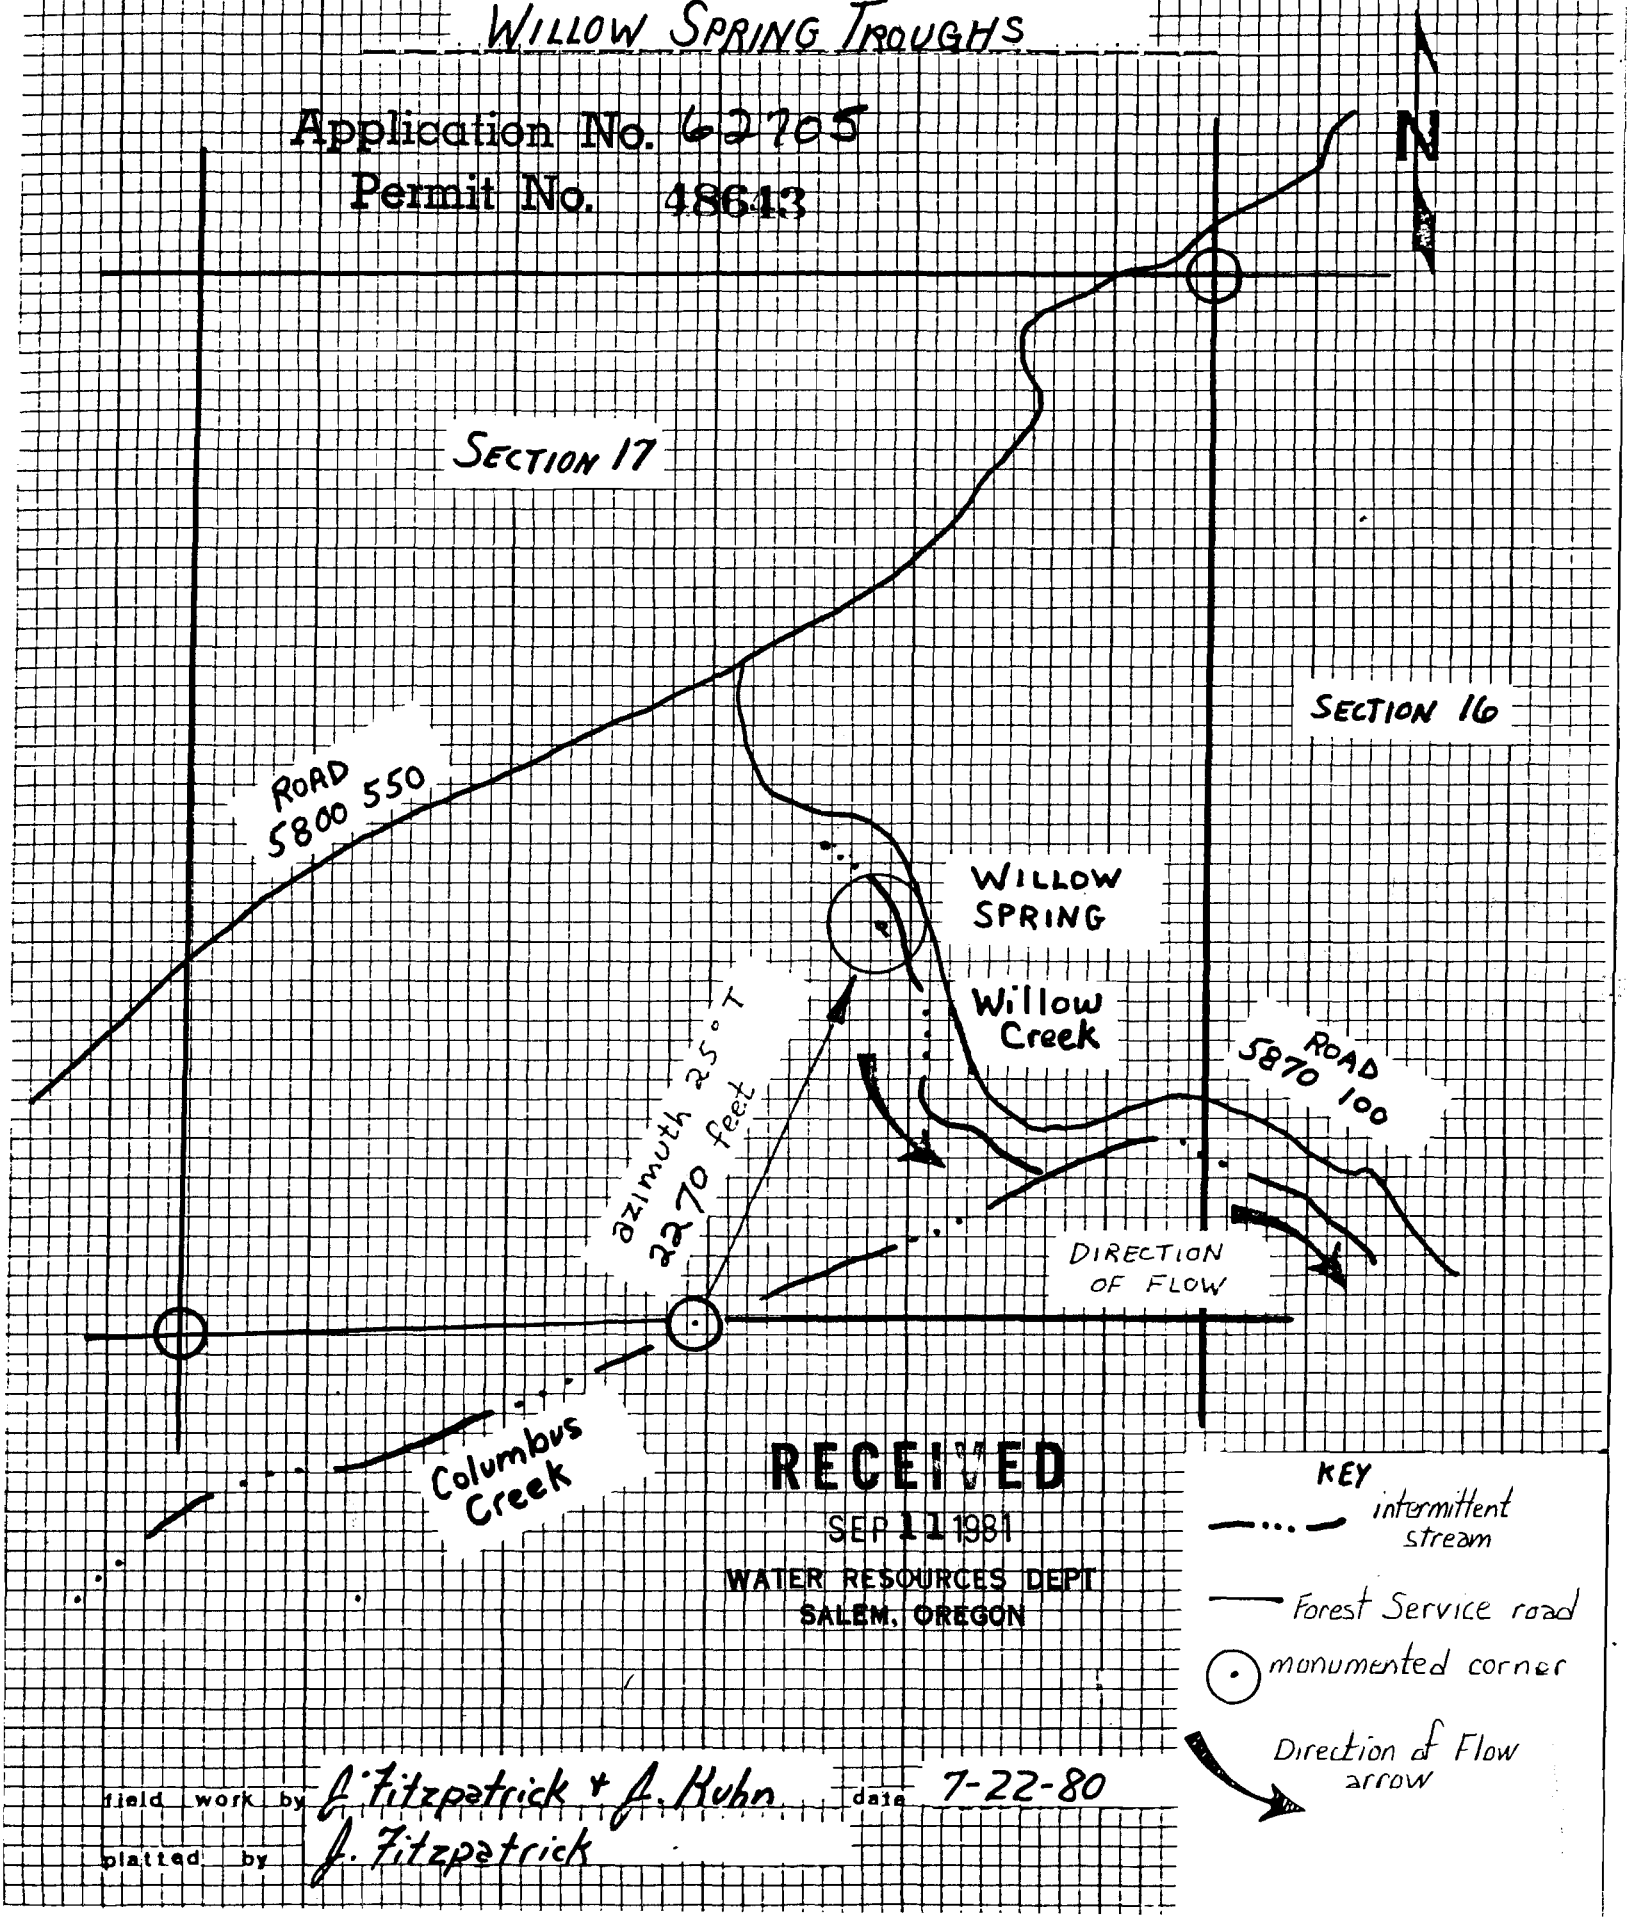

RECEIVED
SEP 11 1981
WATER RESOURCES DEPT
SALEM, OREGON

field work by J. Fitzpatrick & A. Kuhn date 7-22-80

platted by J. Fitzpatrick