


N

SEP 9 1933

LANDS DEPT.
SALEM, OREGON

Application No. 66322
Permit No. 48572

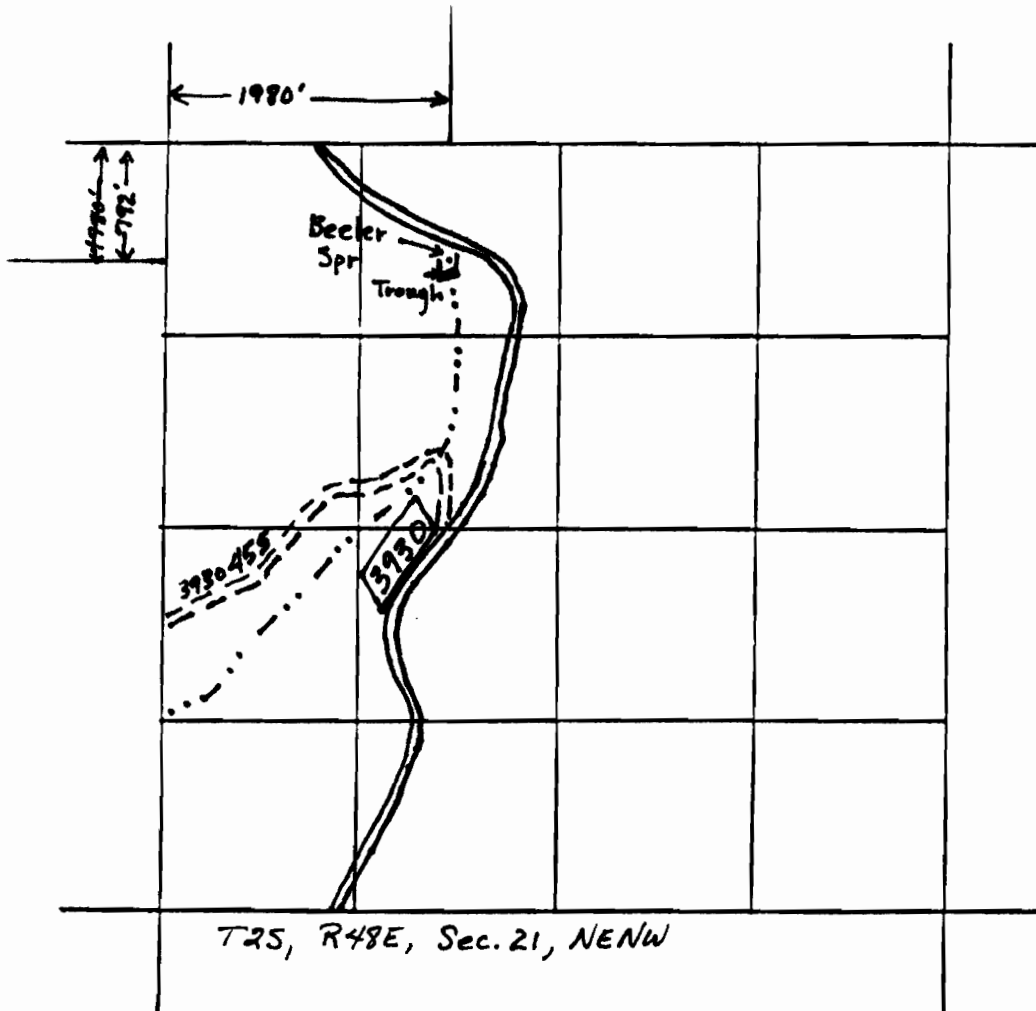

4 inches = 1 mile