


N ↑

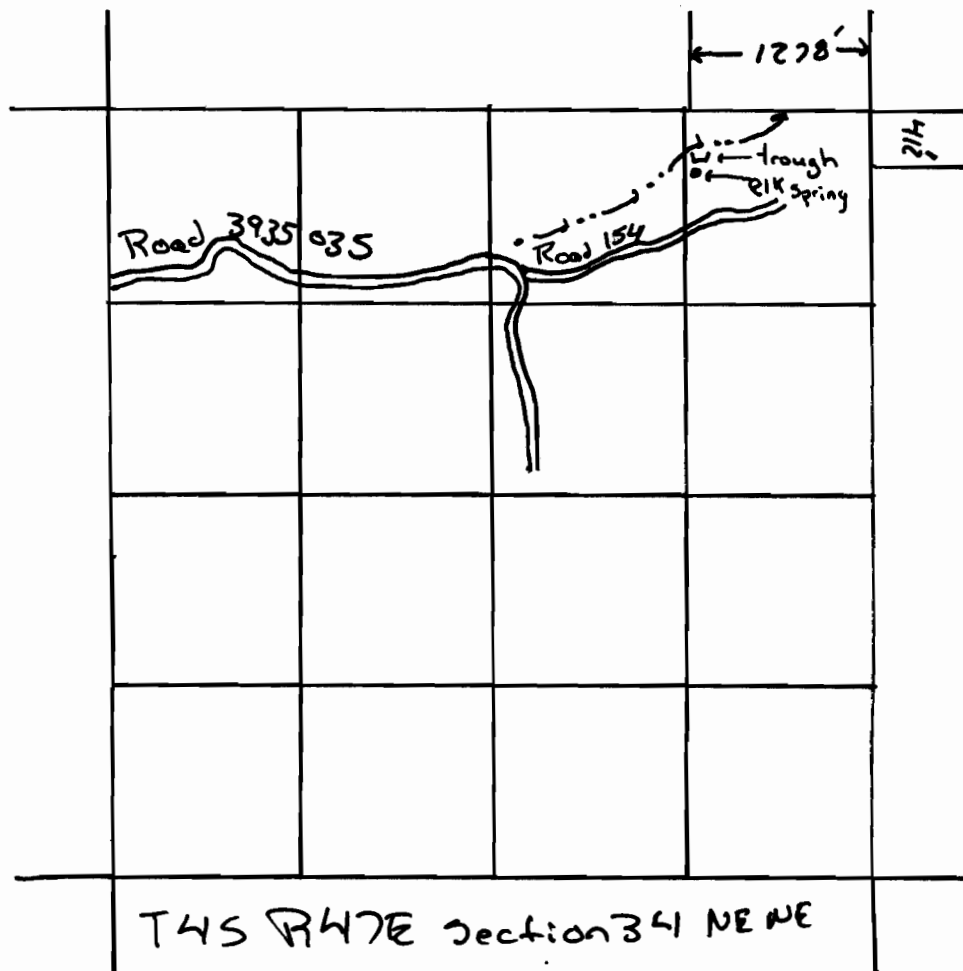

4 inches = 1 mile