


67571

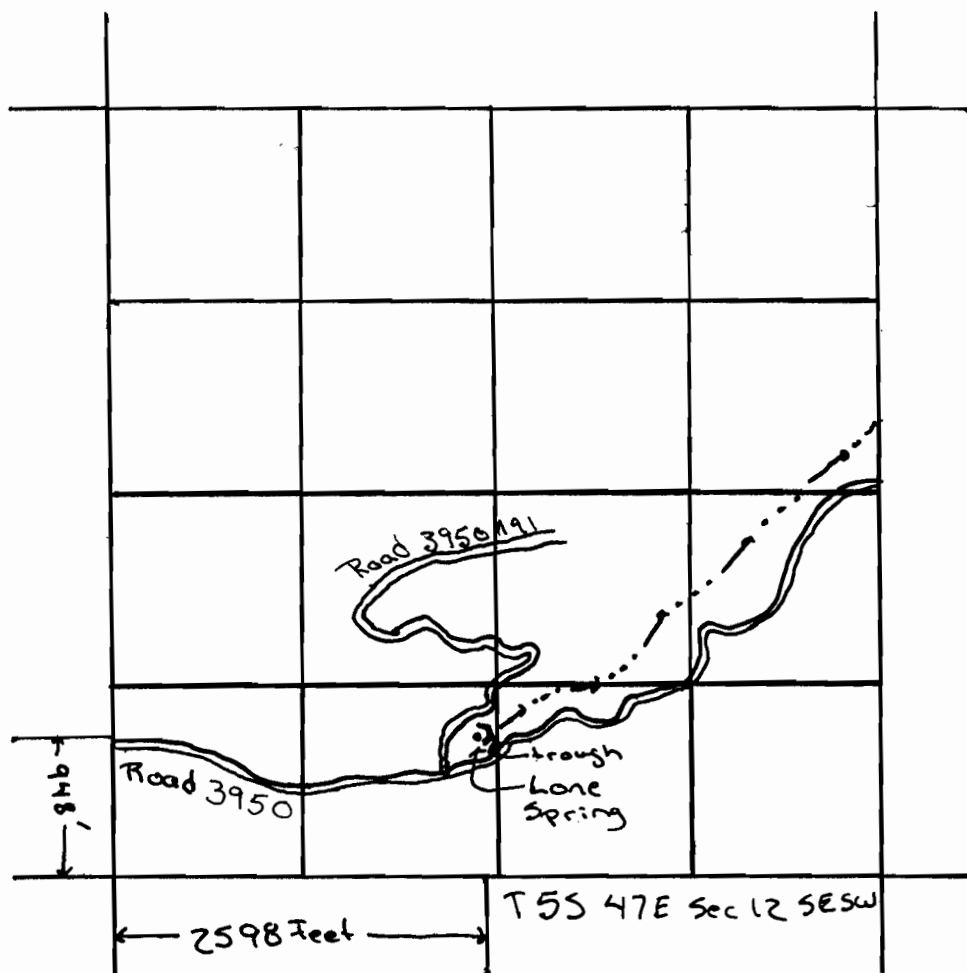

Application # 67571
Permit # 49101
Supersedes 10/18/83 Map-
4 inches = 1 mile