


67572

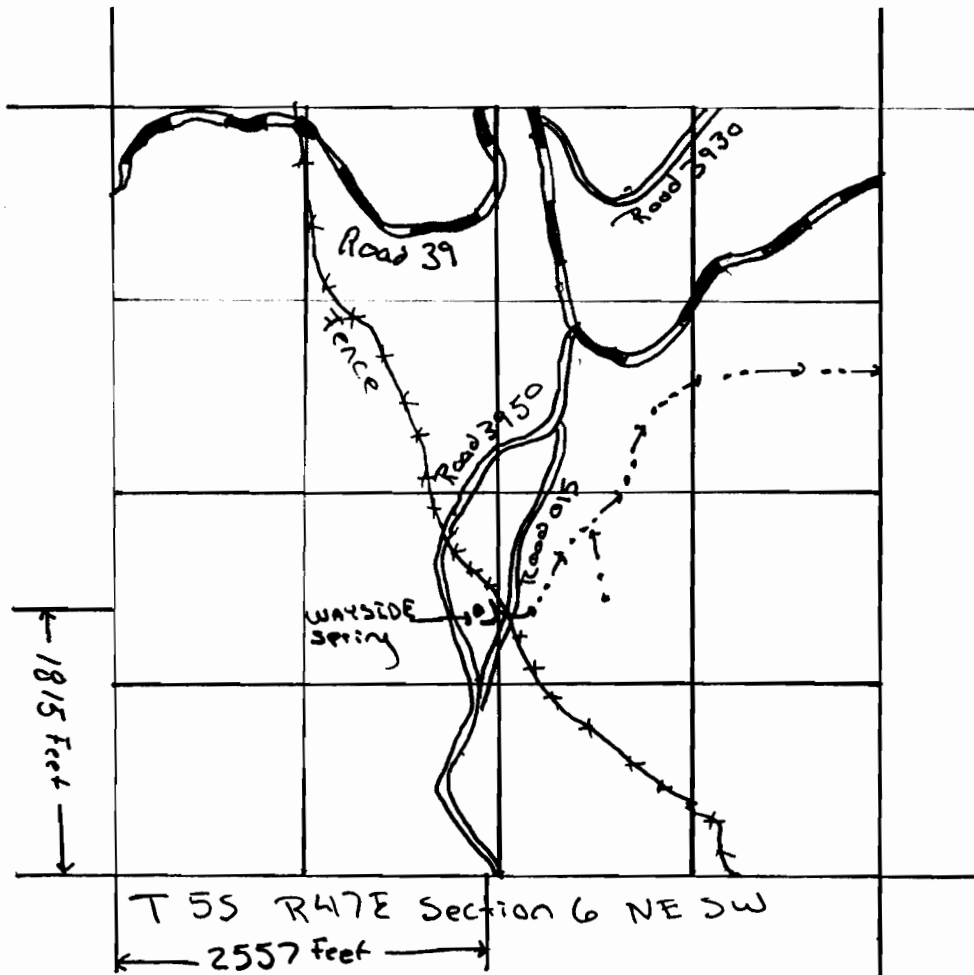

Application # 67572
Permit # 49102

4 inches = 1 mile