


Top Spring

N

Application No. 66311
Permit No. 48561

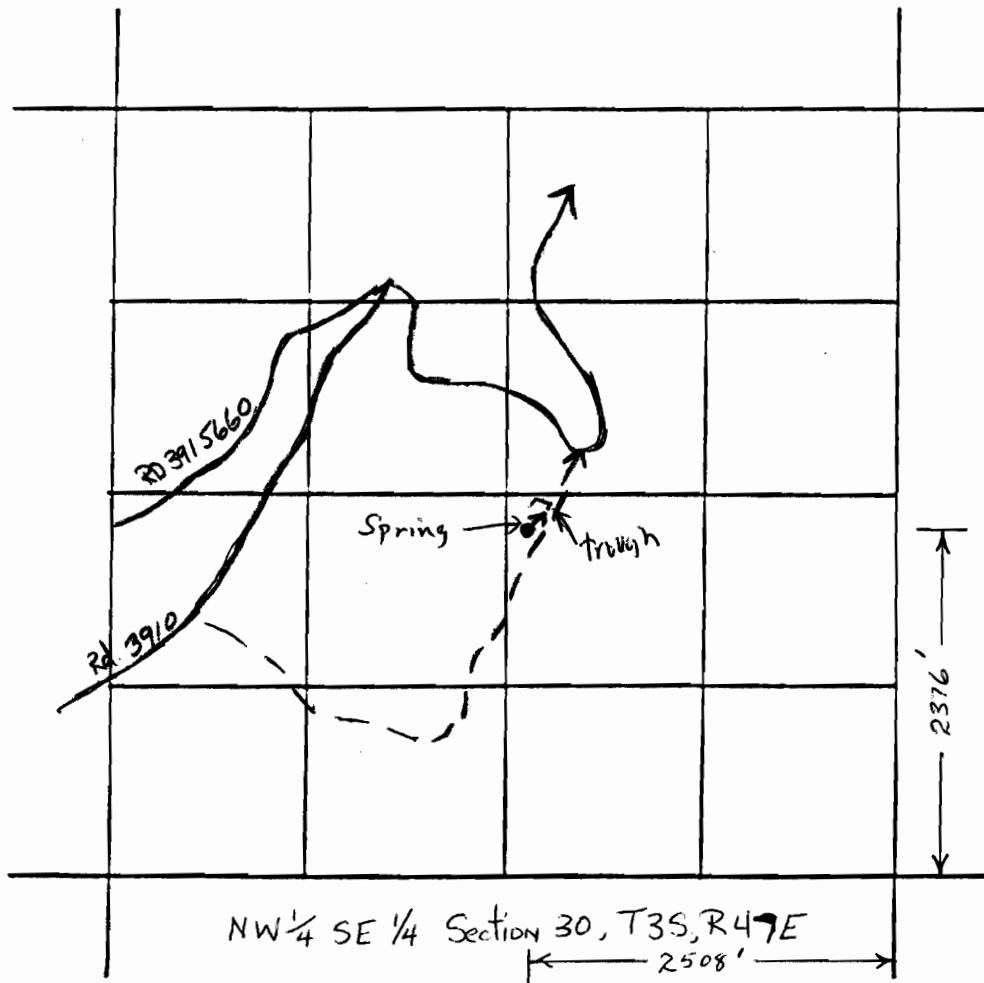

RECEIVED
SEP 9 1933
LANDS DEPT.
SALEM, OREGON