


66312

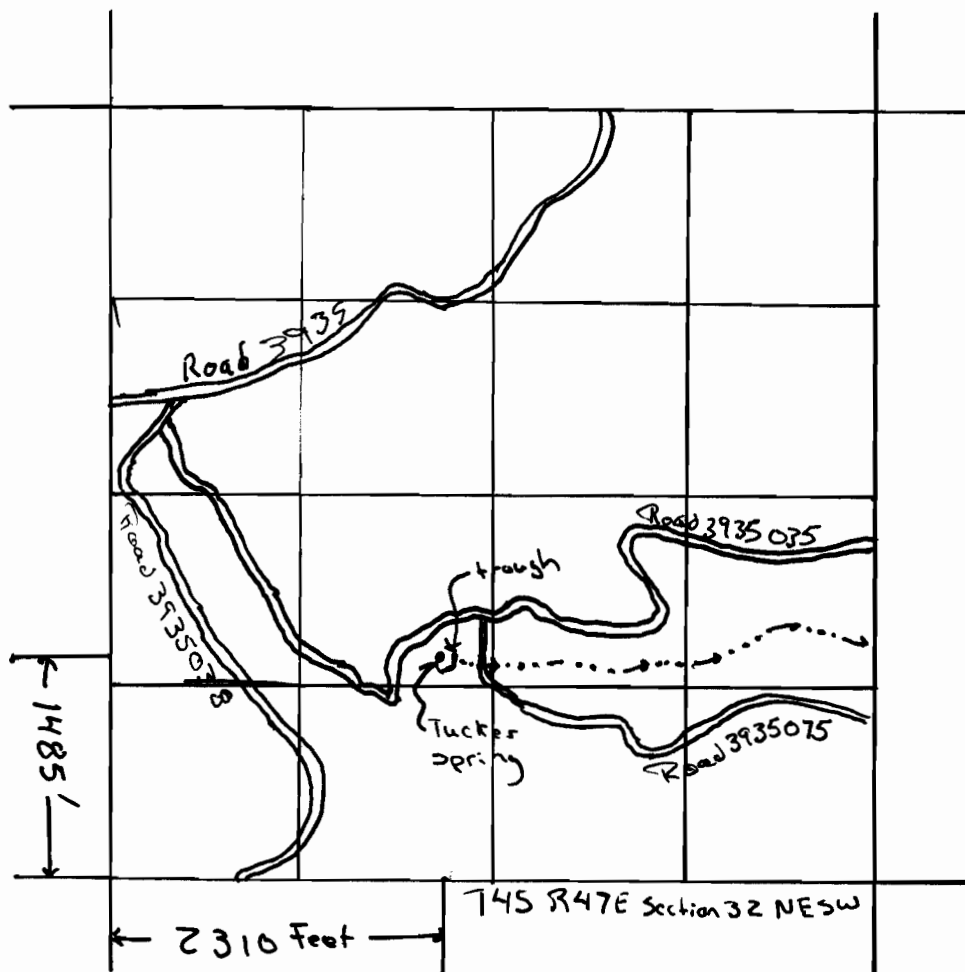

Application # 66312
Grant # 48562

4 inches = 1 mile