
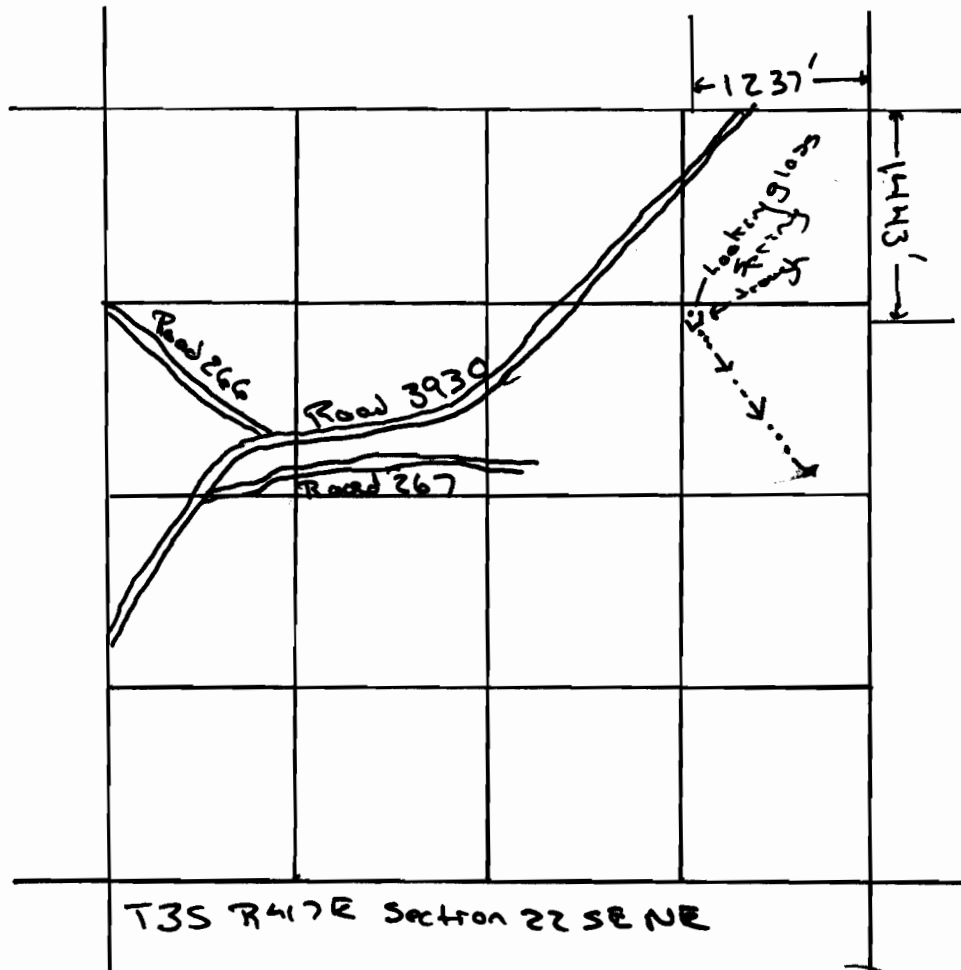


66313

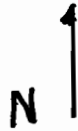

Application # 66313
Permit # 48563

4 inches = 1 mile