


N

Application No. 66316
Permit No. 48566

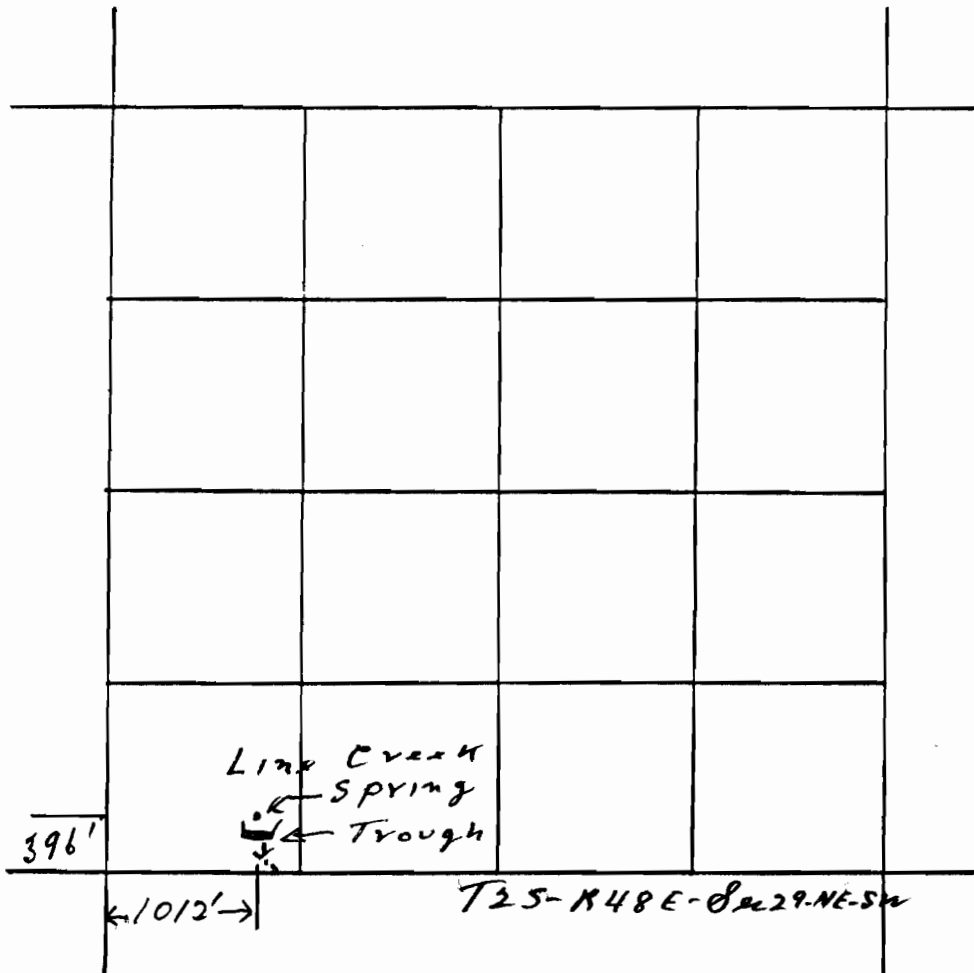

4 inches = 1 mile

RECEIVED
SEP 9 1933
SALEM, OREGON