


N

RECEIVED
SEP 19 1933
WATER RESOURCES DEPT.
SALEM, OREGON

Application No. 66318
Permit No. 48568

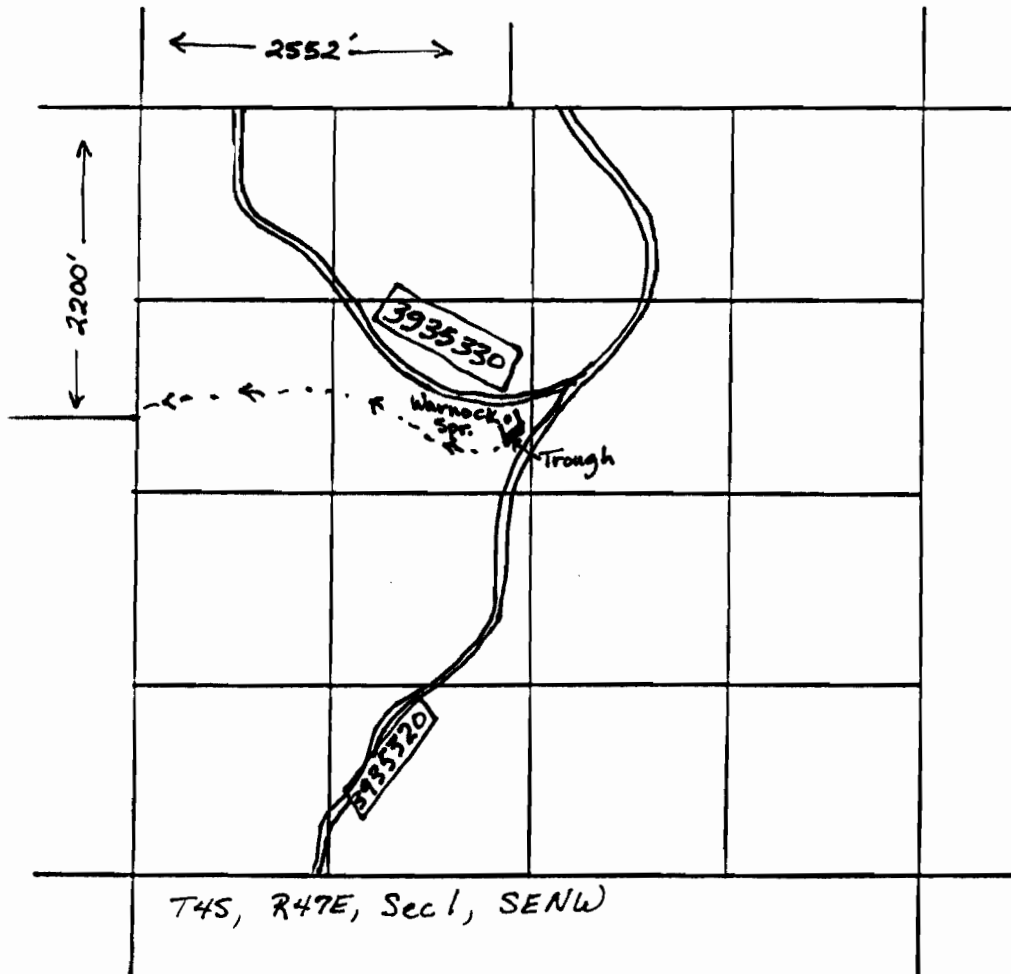


4 inches = 1 mile

N

RECEIVED
SEP 19 1933
WATER RESOURCES DEPT.
SALEM, OREGON

Application No. 66318
Permit No. 48568

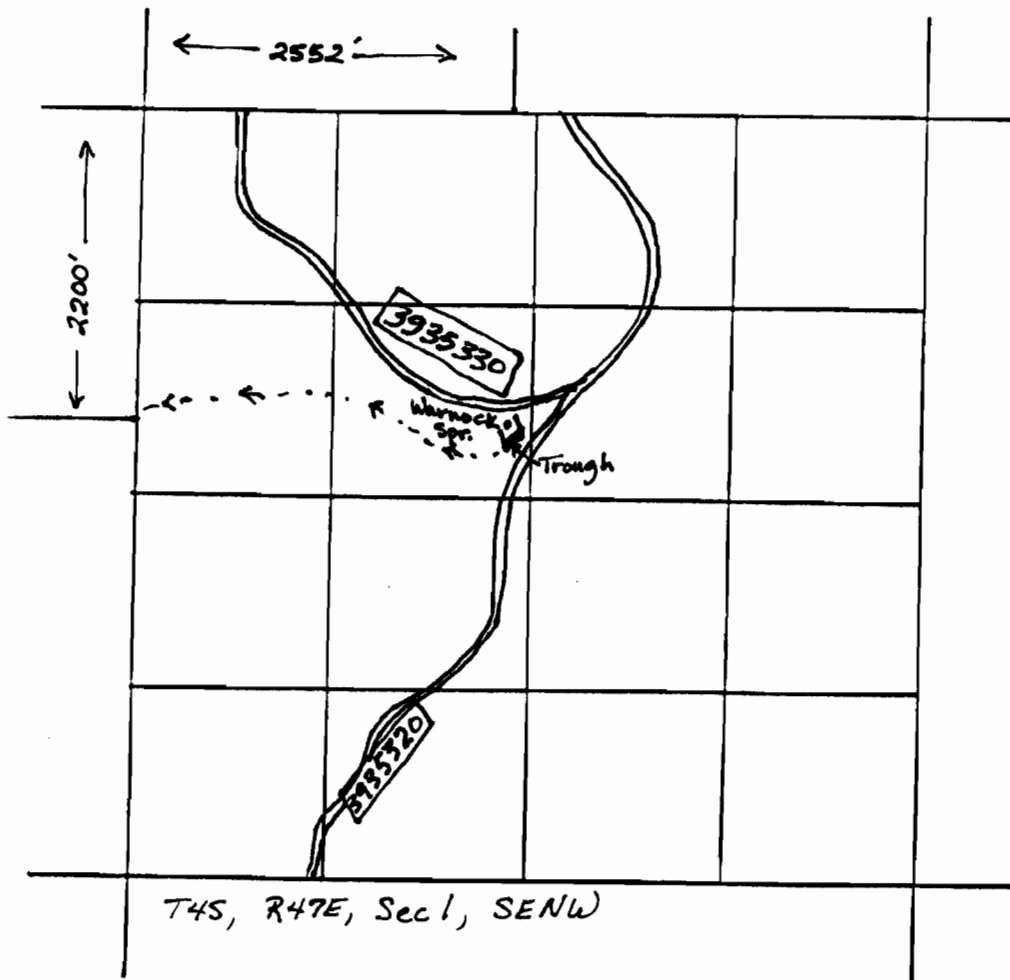

4 inches = 1 mile