
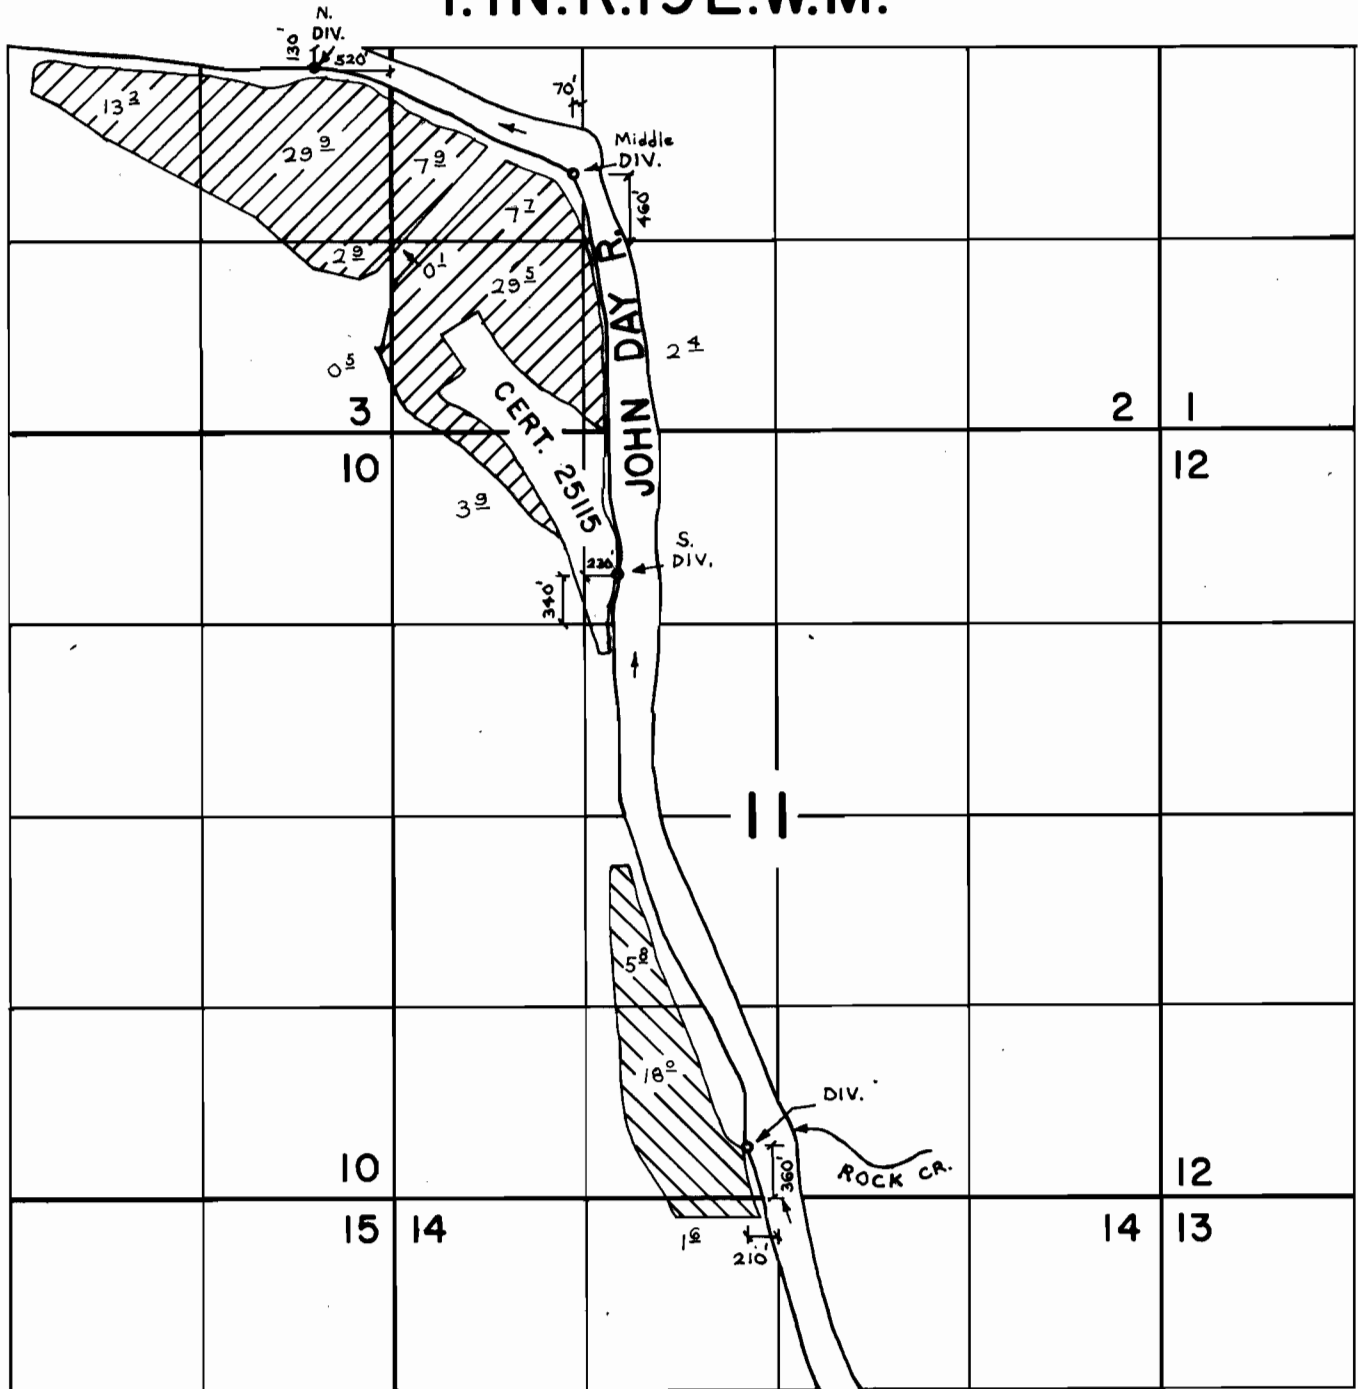


T.1N.R.19E.W.M.

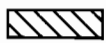

FINAL PROOF SURVEY
UNDER

~~47876~~ ~~35877~~  (Superseded)
Application No. 47877 Permit No. 35878  by VLC
IN NAME OF
BIG SKY RANCH INCORPORATED
See T-2473.)

Surveyed July 13, 1976, by R.G. Mucken