


T. 1N., R. 19E., W. M.

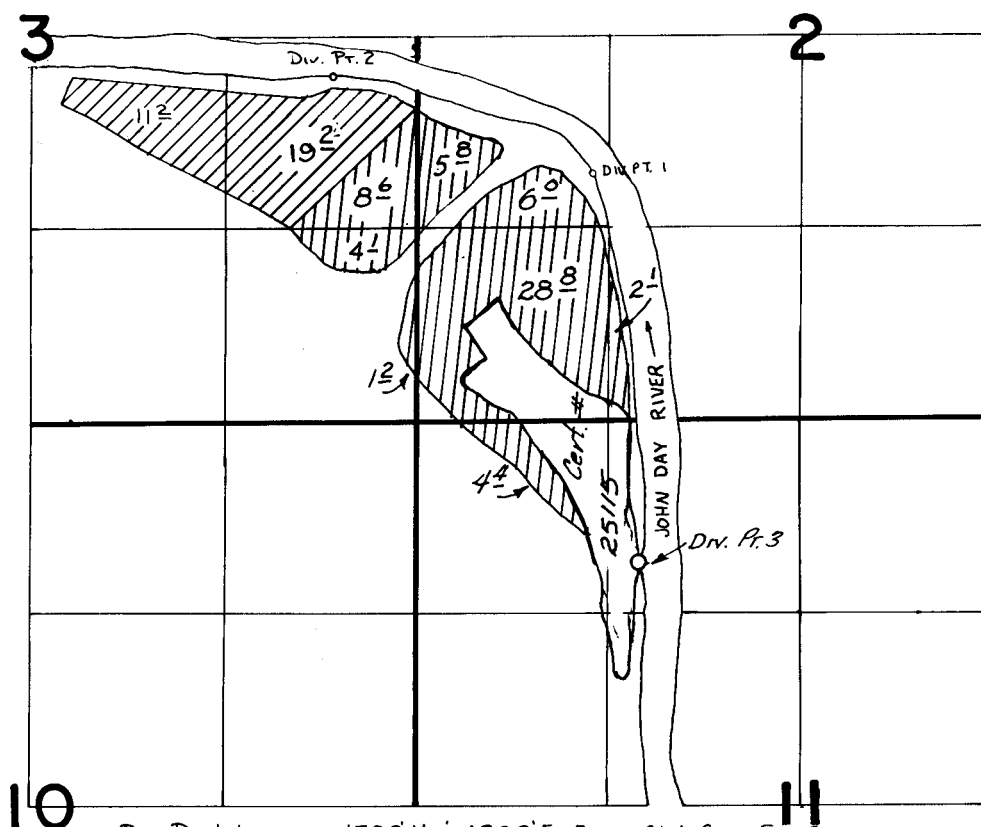

Div. Pt. 1 LOCATED 1700' N. & 1200' E. FROM SW COR. SEC 2
 Div. Pt. 2 LOCATED 2380' N. & 560' W FROM SW COR. SEC 2
 Div. Pt. 3 LOCATED 340' N & 230' E FROM NW 1/16 COR. SEC 11

N
 Scale 1" = 1320'

FINAL PROOF SURVEY UNDER

47876 35877 (re mapped)
TRANSFER 2473
 Application No. **58046** Permit No. **43721**.....
 IN NAME OF

..... **BIG SKY RANCH, INC.**

Surveyed May...20. 1985., by V. Church.....

revised 10/8/98